



H + K INTERNATIONAL

H + K DALLAS INC.
2200 SKYLINE DR.
MESQUITE, TX 75149
214.818.3500

DATE : 06SEP22

DRAWN : EC

CHECKED : AR

SCALE : SEE PLAN

BY	I	I	I	I	I
DESCRIPTION					
REV					
DATE					

TITLE :

SAO-BCK
AS-BUILT LAYOUT

4215 RAINBOW BOULEVARD
KANSAS CITY, KS

THESE DRAWINGS SPECIFICATIONS ARE THE PROPERTY
OF H+K AND SHALL NOT BE REPRODUCED OR COPIED
WITHOUT H+K'S WRITTEN PERMISSION

CUSTOMER :

McDONALD'S
CORPORATION
OAK BROOK, ILLINOIS

STORE # :

04056

SITE ID :


150043

SHEET #

1 OF 1

SHEET :

AB-1

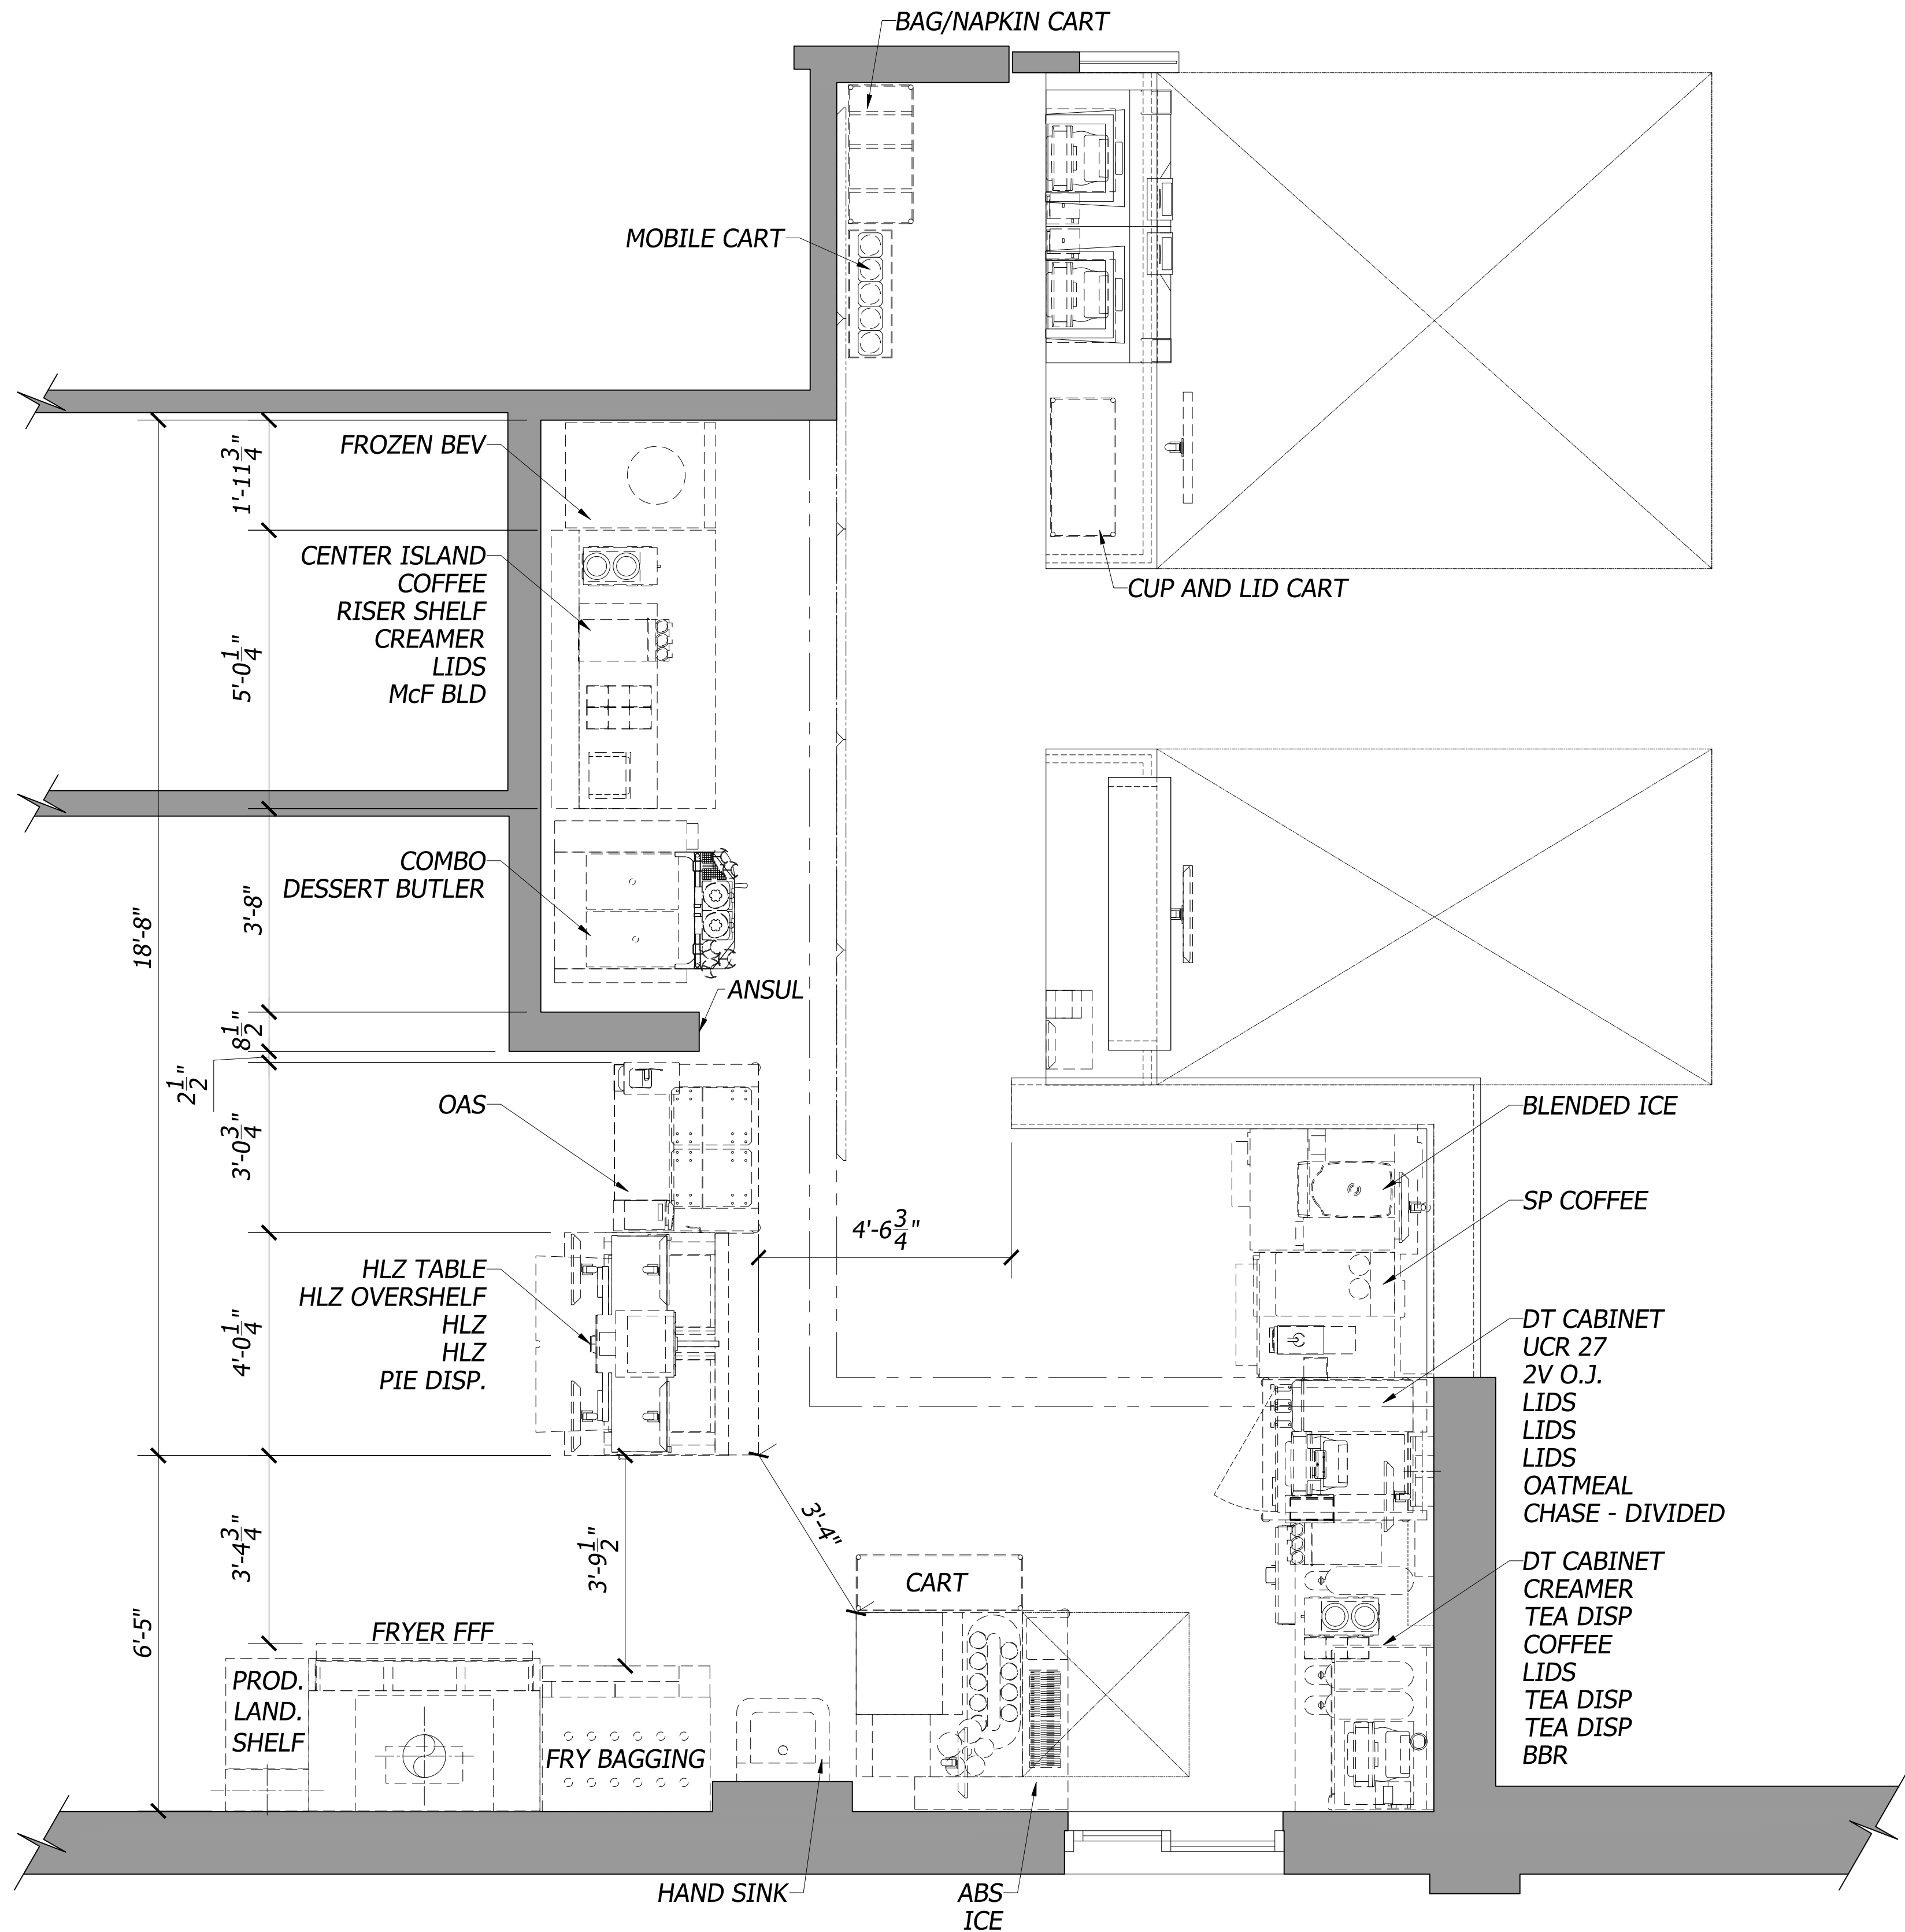

AS-BUILT PLAN

1/2"=1'-0"

LEGEND

- EXISTING EQUIPMENT
- EXISTING TRUSSES
- SERVICE AREA
- OVERHEAD
- EXISTING FULL WALL
- EXISTING LOW WALL

1
A3.0

EXISTING FLOOR PLAN

$\frac{3}{16}'' = 1'-0''$

2 KEY PLAN
A3.0 $3/32" = 1'-0"$

2 PROPOSED FLOOR PLAN
A3.0 3/16" = 1'-0"



4 PHOTOS (EXISTING CONDITIONS)
A3.0 N.T.S.