



McDonalds Existing Conditions 360° Virtual Tour



STOREFRONT

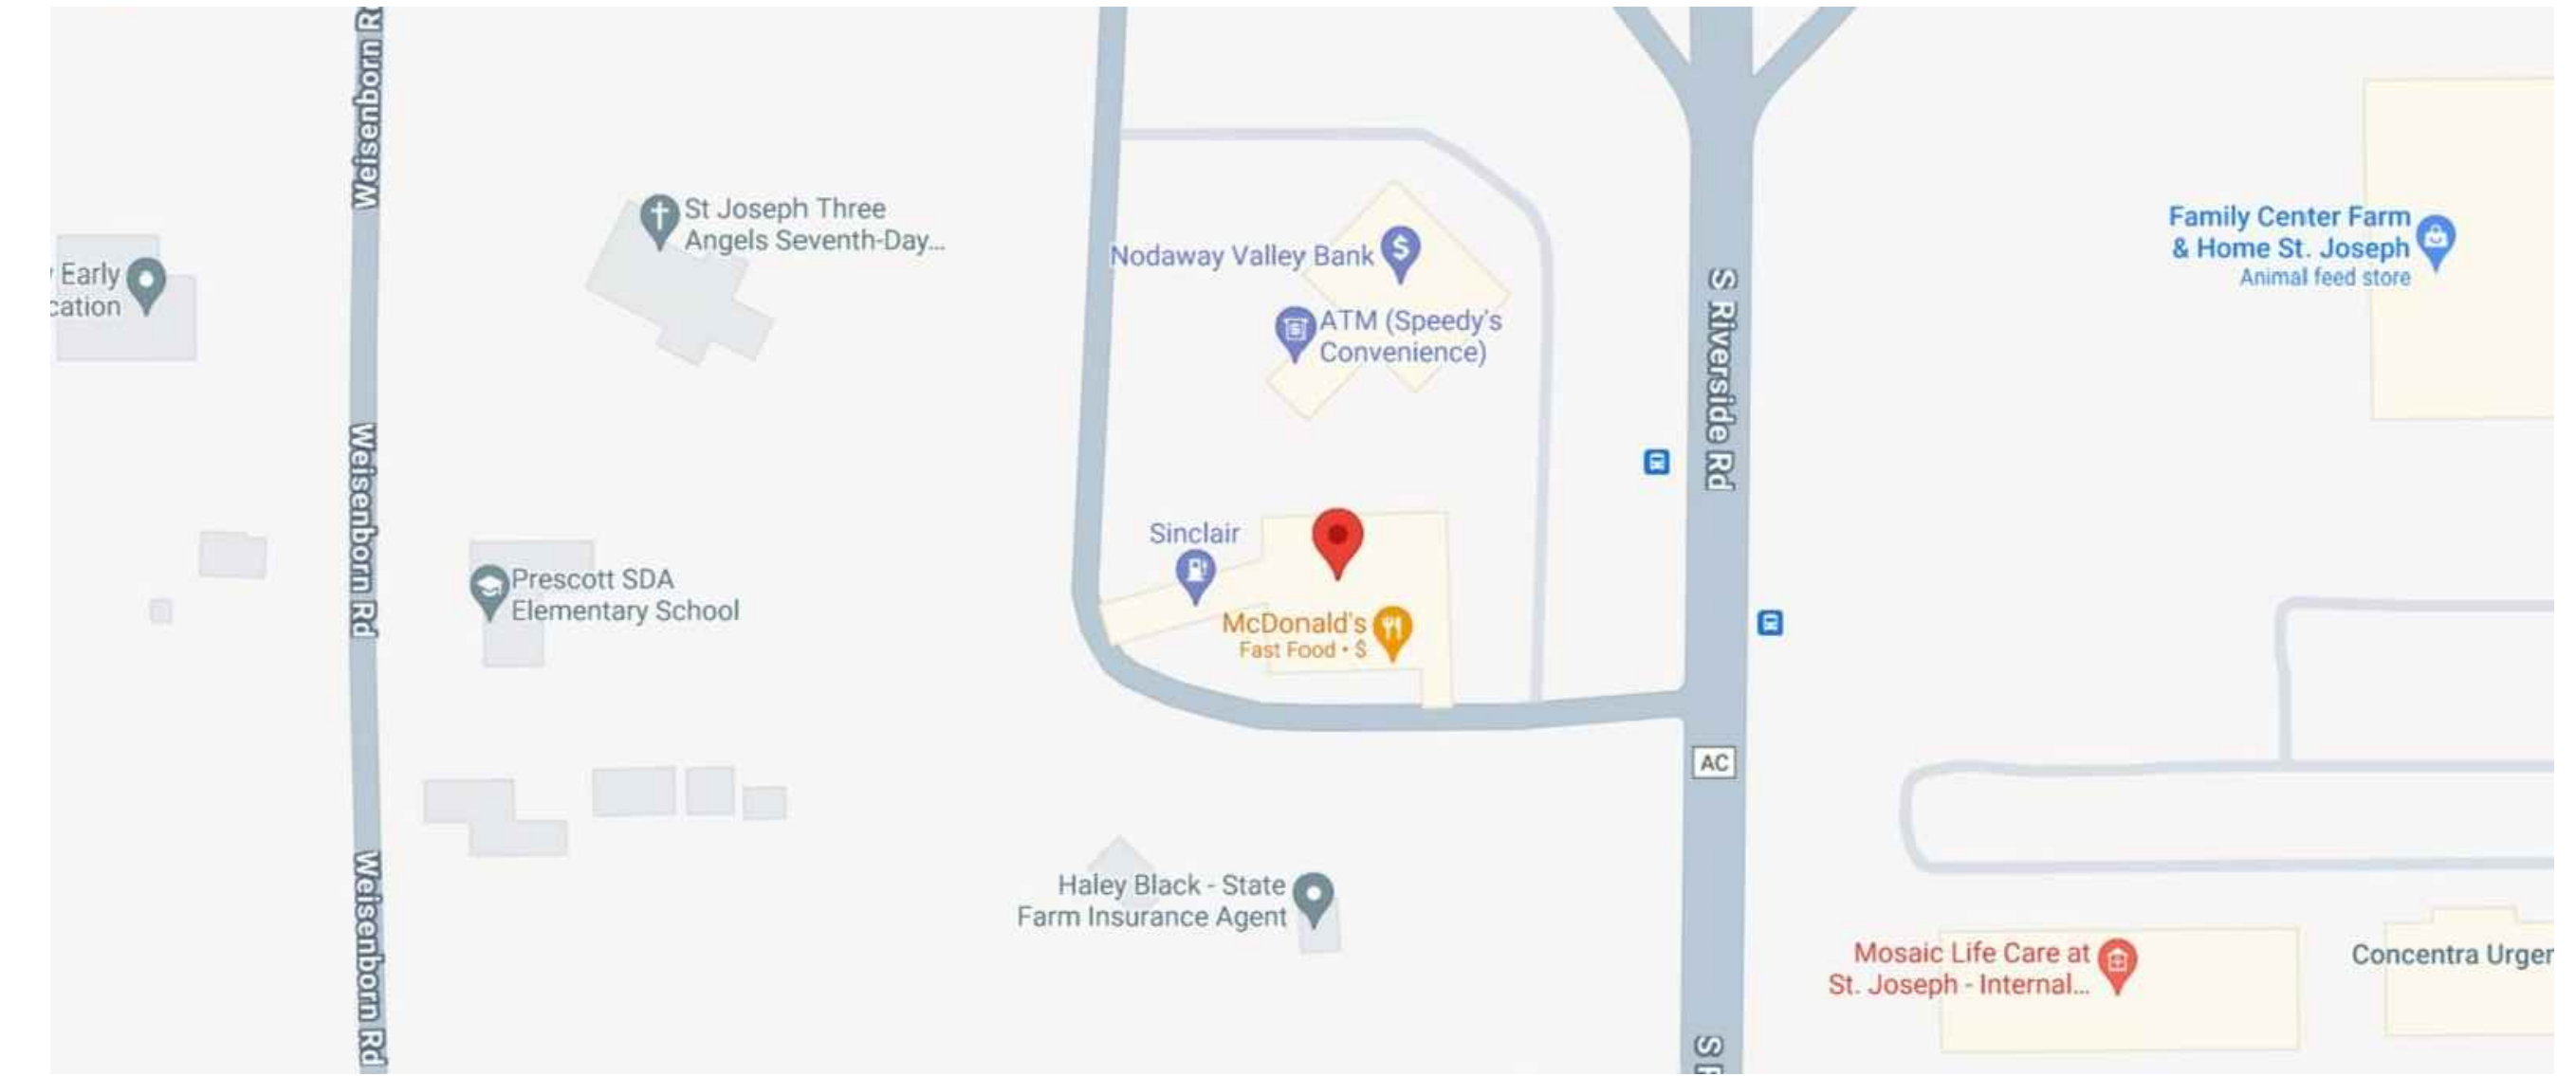


VICINITY MAP


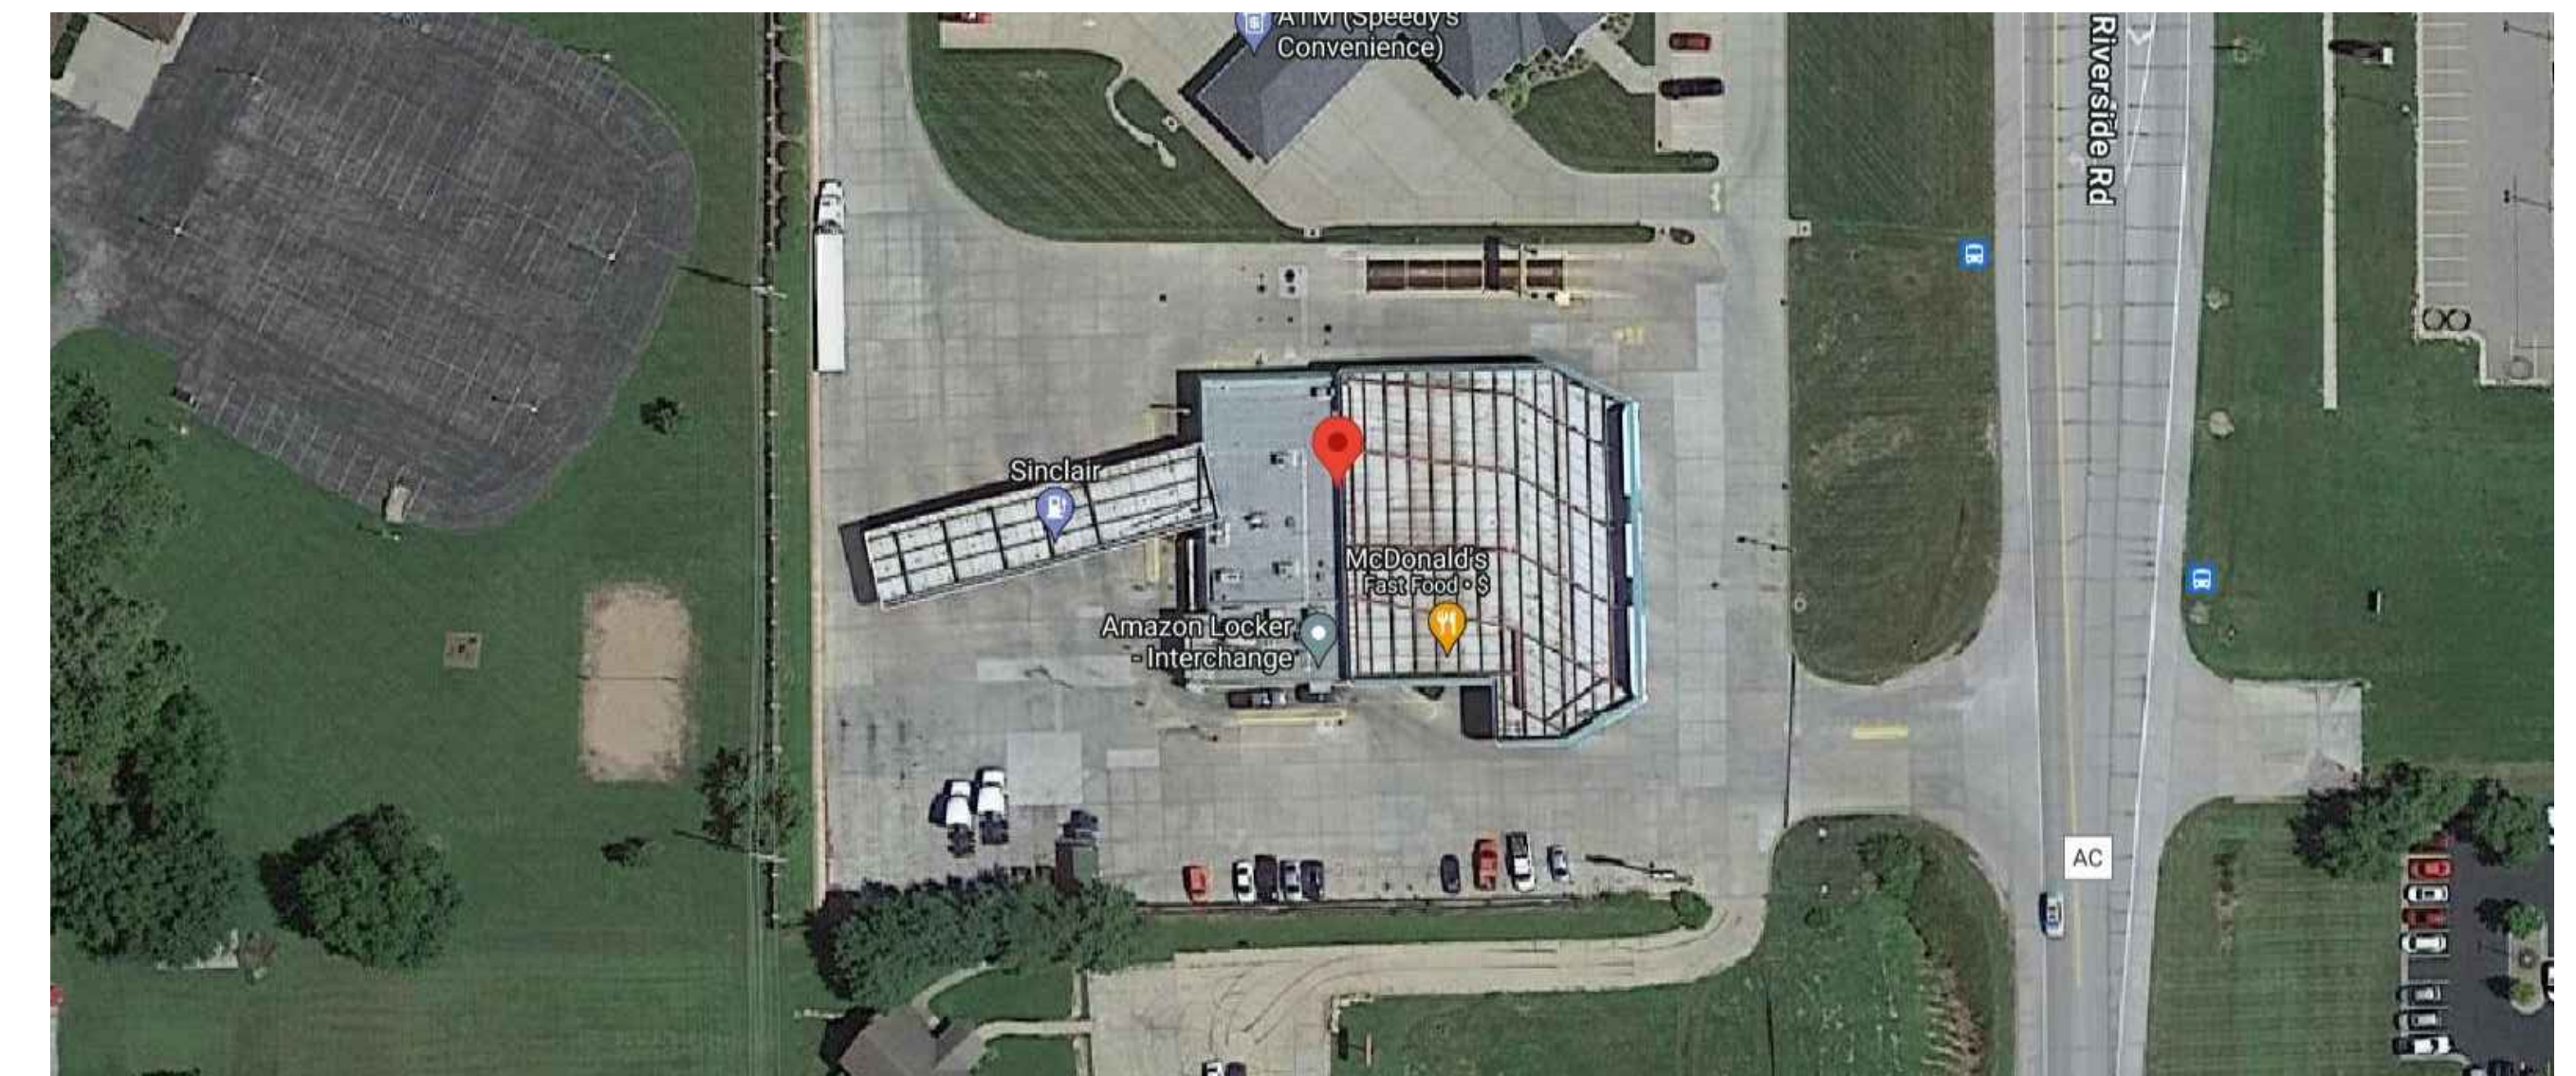


AERIAL PHOTO

Store Name:	ST. JOSEPH, MO.
National Store No.	31427
Store ID:	024-1140
Address:	1310 S. RIVERSIDE RD. ST. JOSEPH, MO 64507


sevan
SURVEY
[CLICK FOR A VIRTUAL TOUR](#)

C:\Users\ClarkMichael\Desktop\024-1140 (31427) CAD\024-1140 (31427) CAD\Current\CAD- SAO\024-1140 (31427) As-Built CAD.dwg November 29, 2023 - 12:25pm ClarkMichael

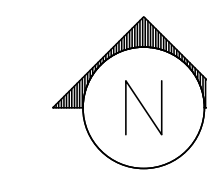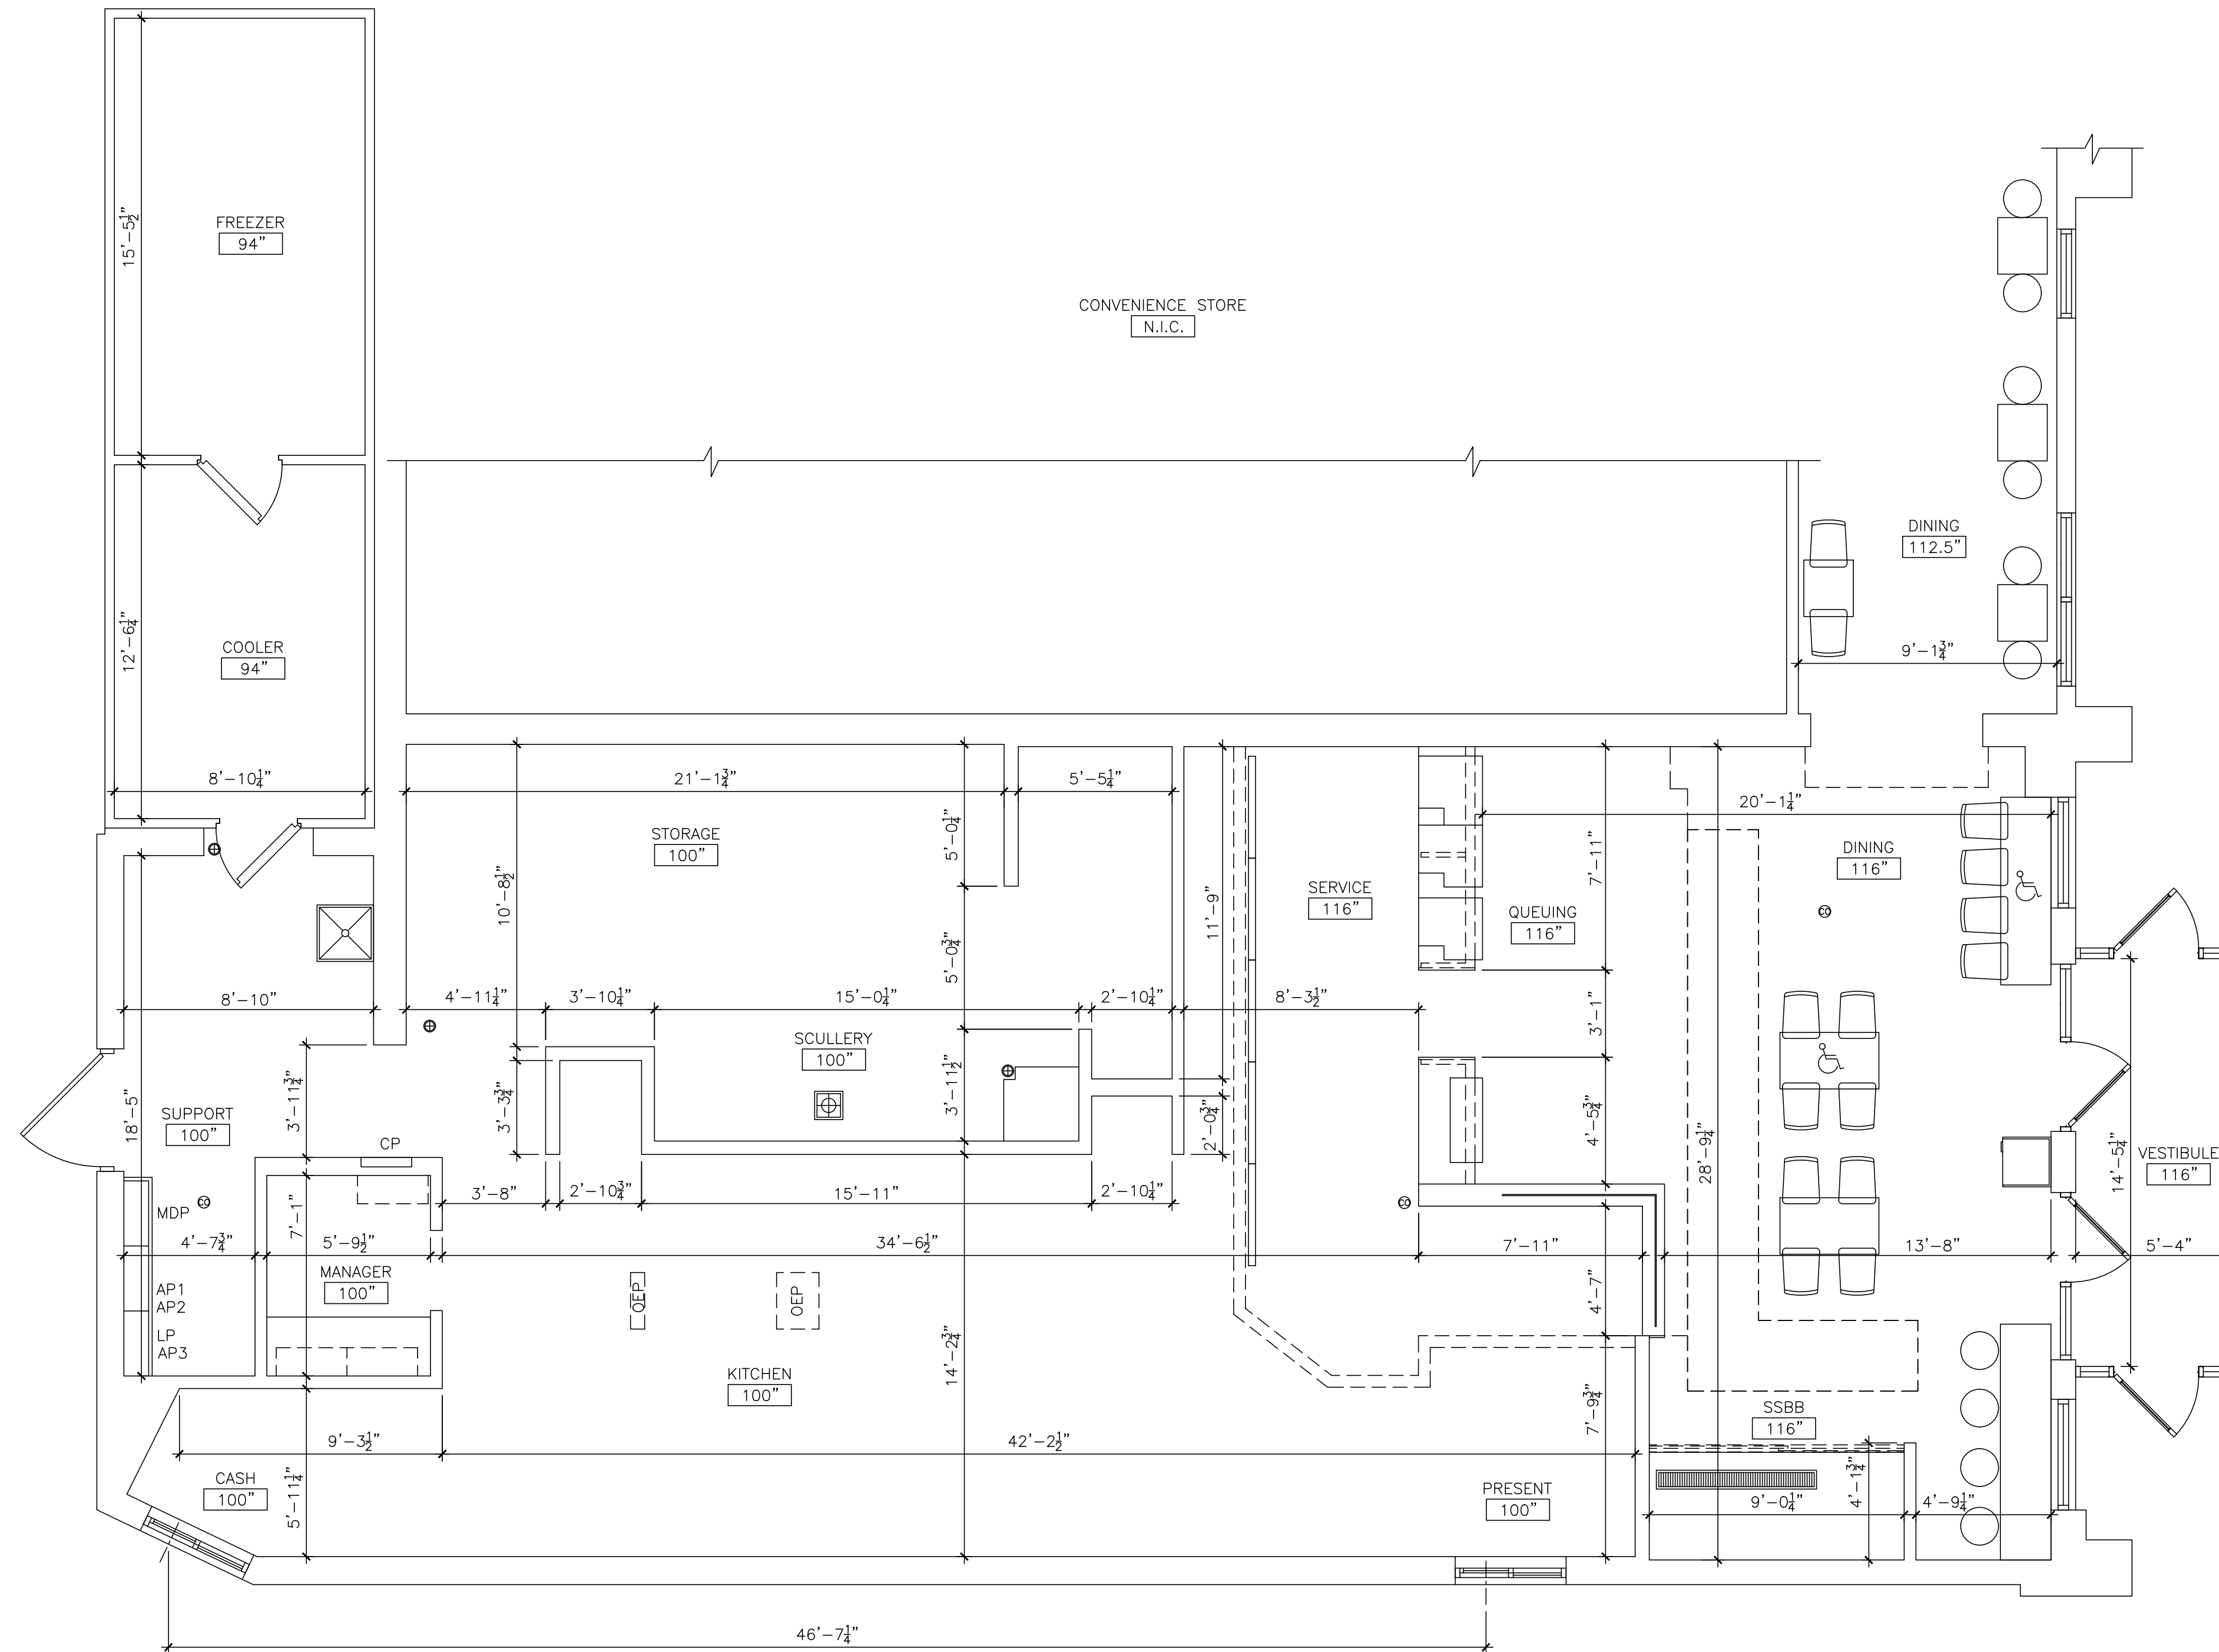

1
A1.0

EXISTING FLOOR PLAN - LEVEL 1

SCALE: 1/4" = 1'-0"
TOTAL SQ FT = 2,450
TOTAL SEATING = 24

REVISIONS		
NO.	DATE	DESCRIPTION
-	-	-
-	-	-
SEAL

SEAL NOTE

PREPARED FOR
McDonald's USA LLC

These drawings and specifications are the confidential and proprietary property of McDonald's USA, LLC and shall not be copied or reproduced without written authorization. The contract documents were prepared for use on this specific site in conjunction with its issue date and are not suitable for use on a different site or at a later time. Use of these drawings for reference or example on another project requires the services of properly licensed architects and engineers. Reproduction of the contract documents for reuse on another project is not authorized.

PROJECT DESCRIPTION
EXISTING CONDITIONS

PROJECT LOCATION
McDonald's
1310 S. RIVERSIDE RD.
ST. JOSEPH, MO
64507

SHEET TITLE
FLOOR PLAN


SHEET MANAGEMENT
PROJECT NO.: 024-1140
DATE ISSUED: 11/28/2023
DRAWN BY: MJC
REVIEWED BY: JA


NATIONAL STORE #
31427

SHEET NUMBER
A1.0
EX. FLOOR PLAN

Submittal Type - AS-BUILT

C:\Users\ClarkMichael\Desktop\024-1140 (31427) CAD\Current\CAD- SAO\024-1140 (31427) As-Built CAD.dwg November 29, 2023 - 12:25pm ClarkMichael

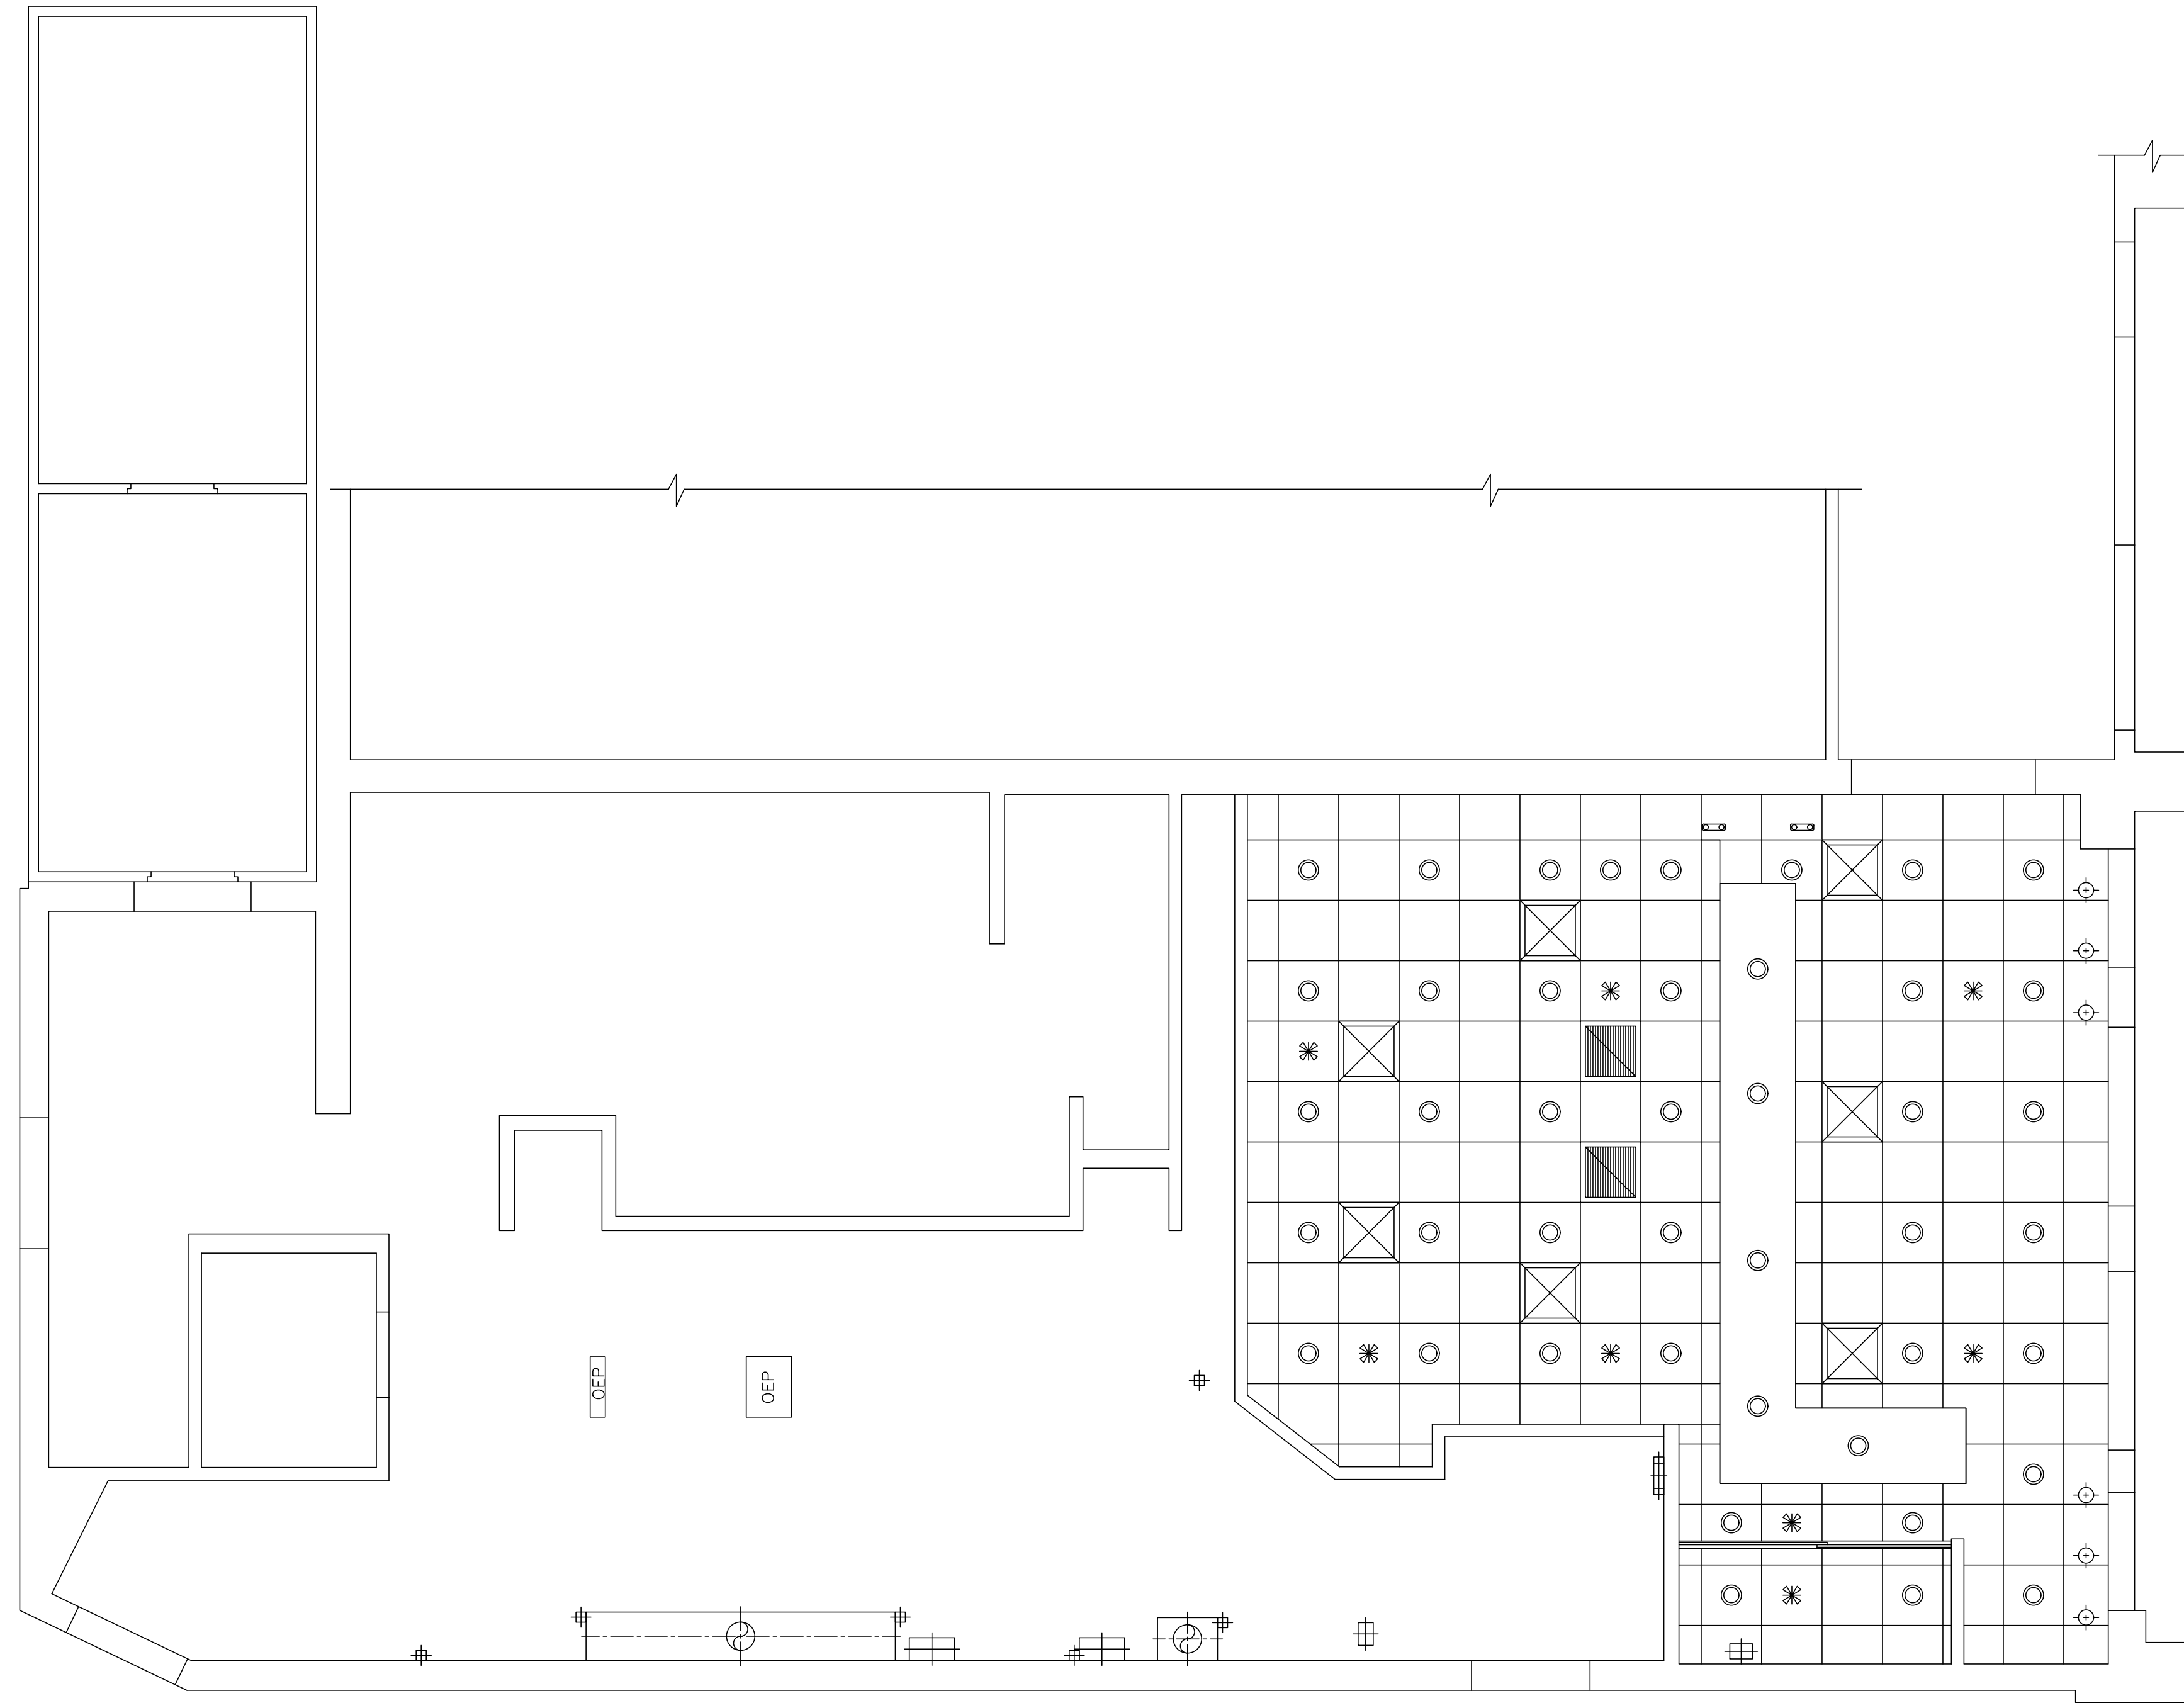

 1 EXISTING REFLECTED CEILING PLAN
A1.1 SCALE: 1/4" = 1'-0"

sevan
MULTI-SITE SOLUTIONS
DESIGN LLC.

Regional Office:
37704 Hills Tech Drive
Farmington Hills, MI 48331
Telephone: 734-307-4465

Corporate Office:
3025 Highland Parkway #850
Downers Grove, IL 60515
info@sevensolutions.com www.sevensolutions.com

SAFETY - INTEGRITY - SUSTAINABILITY

REVISIONS		
NO.	DATE	DESCRIPTION
-	-	-
-	-	-
SEAL

SEAL NOTE

PREPARED FOR

McDonald's USA LLC

These drawings and specifications are the confidential and proprietary property of McDonald's USA, LLC and shall not be copied or reproduced without written authorization. The contract documents were prepared for use on this specific site in conjunction with its issue date and are not suitable for use on a different site or at a later time. Use of these drawings for reference or example on another project requires the services of properly licensed architects and engineers. Reproduction of the contract documents for reuse on another project is not authorized.

PROJECT DESCRIPTION
**EXISTING
CONDITIONS**

PROJECT LOCATION
**McDonald's
1310 S. RIVERSIDE RD.
ST. JOSEPH, MO
64507**

SHEET TITLE
**REFLECTED
CEILING
PLAN**

SHEET MANAGEMENT
PROJECT NO.: 024-1140
DATE ISSUED: 11/28/2023
DRAWN BY: MJC
REVIEWED BY: JA

NATIONAL STORE #
31427

SHEET NUMBER
A1.1
EX. RCP

Submittal Type - AS-BUILT

REVISIONS		
NO.	DATE	DESCRIPTION
-	-	-
-	-	-
SEAL

SEAL NOTE

PREPARED FOR
McDonald's USA LLC

These drawings and specifications are the confidential and proprietary property of McDonald's USA, LLC and shall not be copied or reproduced without written authorization. The contract documents were prepared for use on this specific site in conjunction with its issue date and are not suitable for use on a different site or at a later time. Use of these drawings for reference or example on another project requires the services of properly licensed architects and engineers. Reproduction of the contract documents for reuse on another project is not authorized.

PROJECT DESCRIPTION
EXISTING CONDITIONS


PROJECT LOCATION
**McDonald's
1310 S. RIVERSIDE RD.
ST. JOSEPH, MO
64507**

SHEET TITLE
**KITCHEN
EQUIPMENT PLAN**


SHEET MANAGEMENT
PROJECT NO.: 024-1140
DATE ISSUED: 11/28/2023
DRAWN BY: MJC
REVIEWED BY: JA

NATIONAL STORE #
31427


SHEET NUMBER
K1.0
EX. EQUIPMENT PLAN

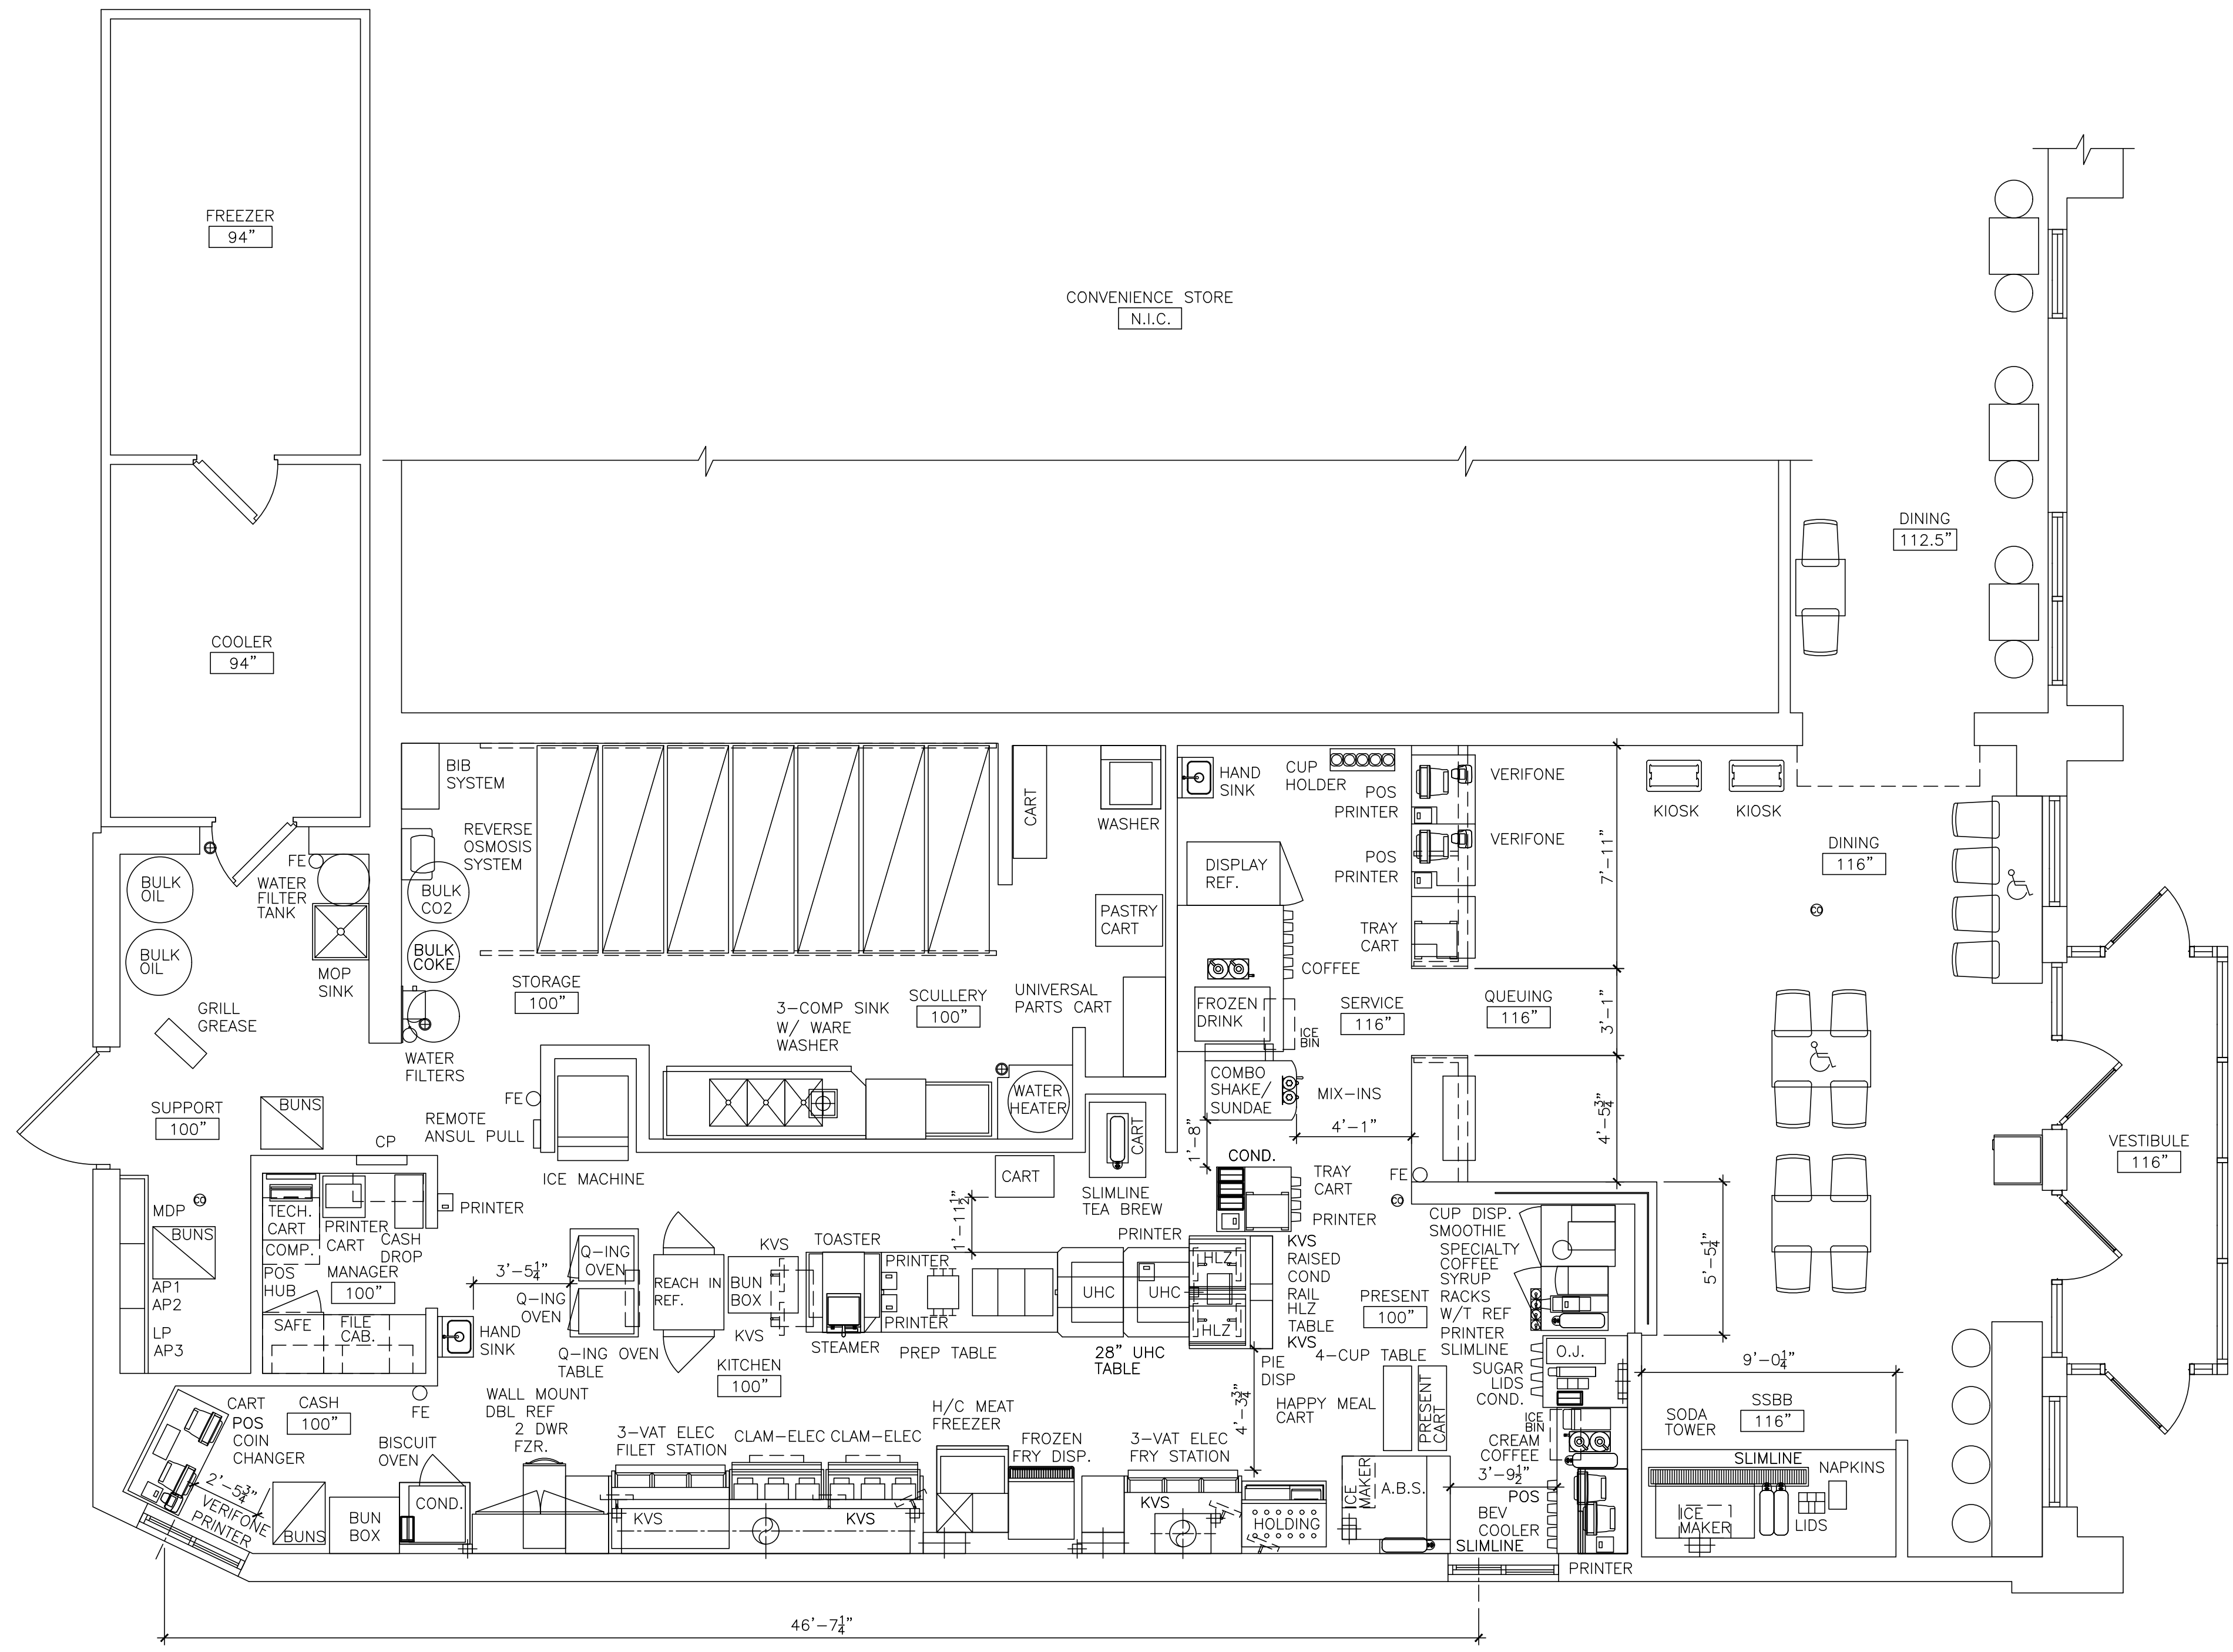

1 EXISTING EQUIPMENT PLAN
K1.0 SCALE: 1/4" = 1'-0"

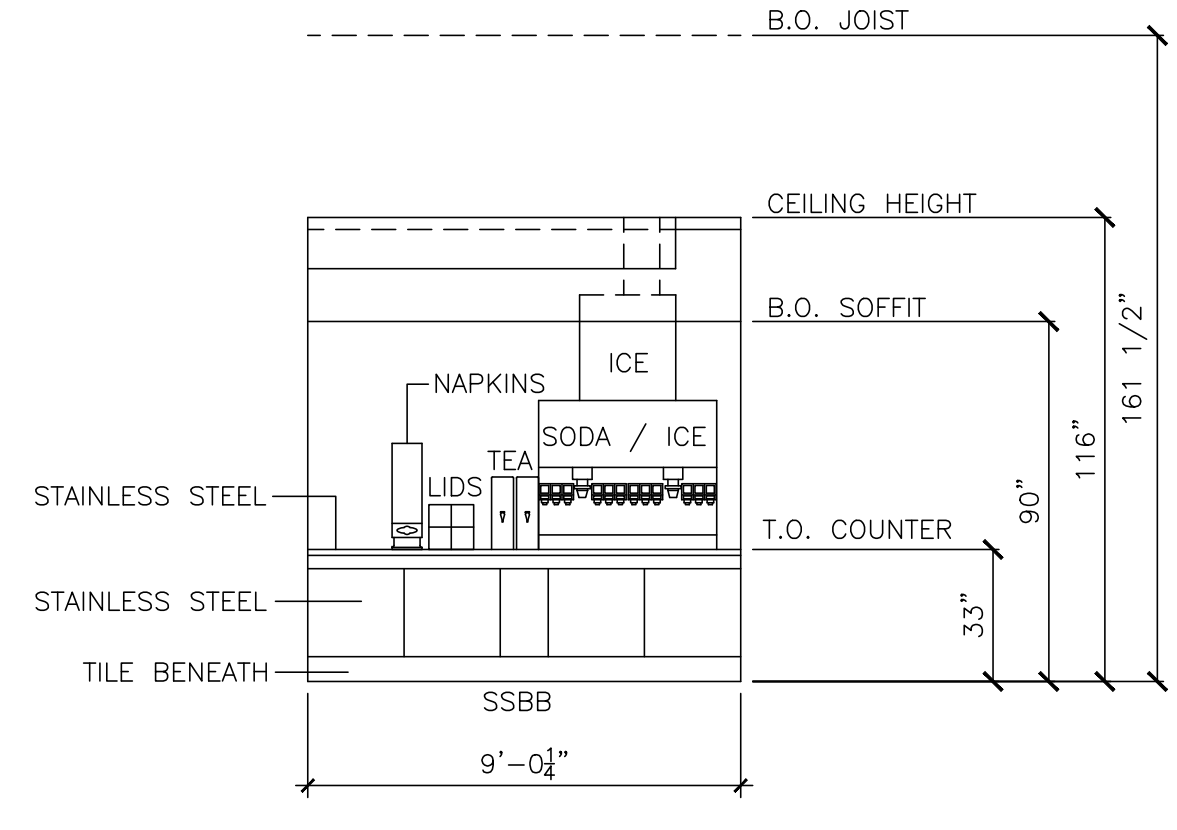

2 EXISTING SSBB COUNTER ELEVATION
K1.0 SCALE: 1/4" = 1'-0"

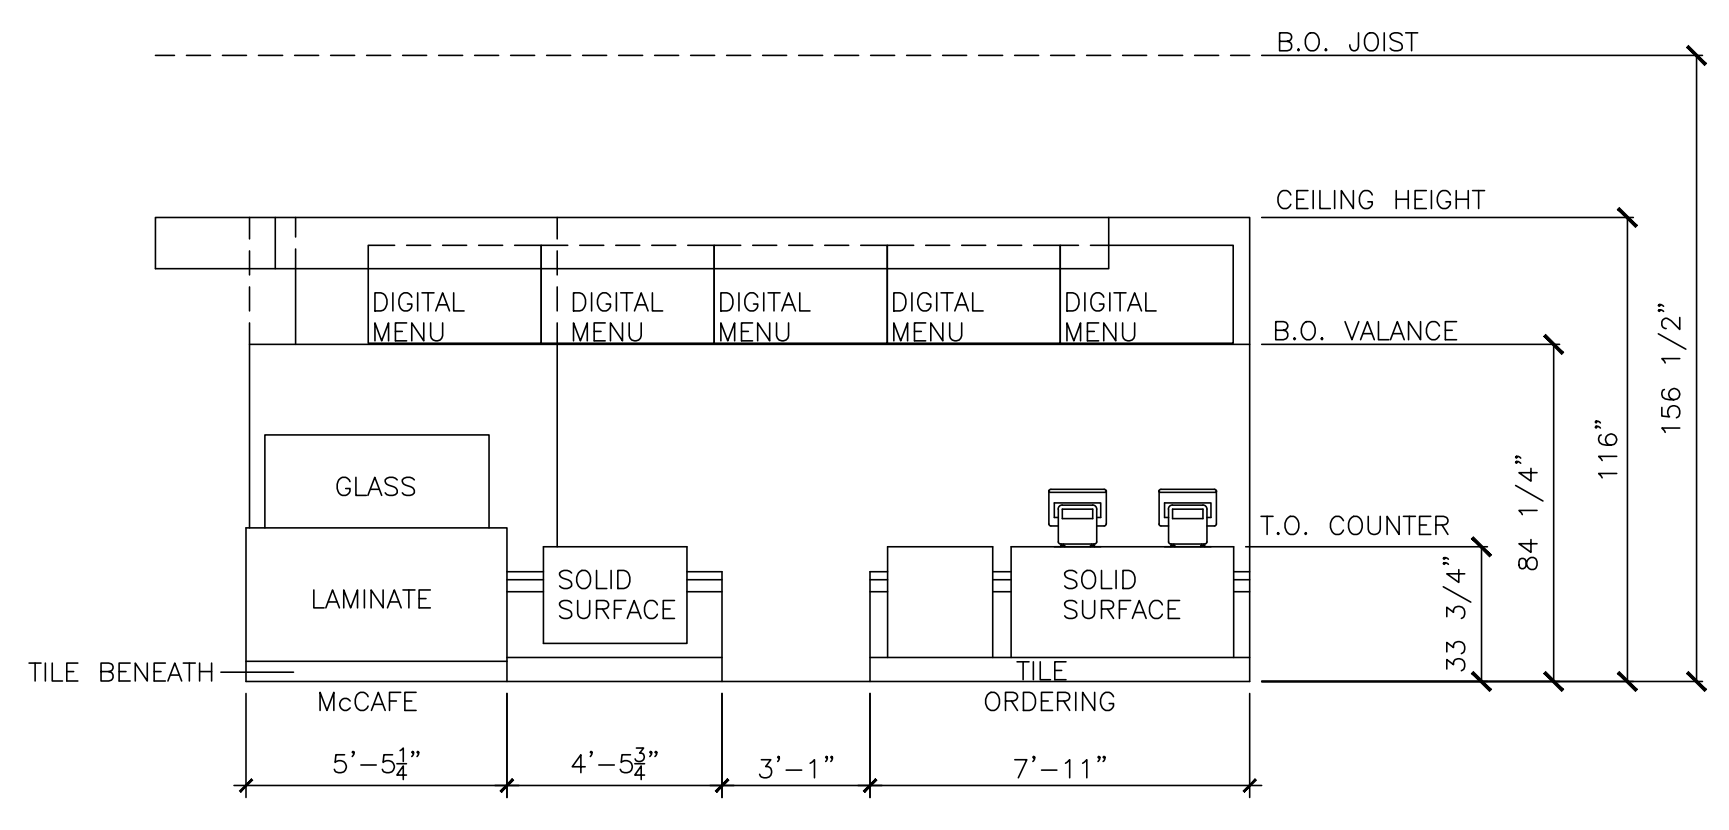

3 EXISTING FRONT COUNTER ELEVATION
K1.0 SCALE: 1/4" = 1'-0"