## GENERAL FLOOR PLAN NOTES

ALL EXIT DOORS SHALL BE KEYLESS IN THE DIRECTION OF EGRESS.

THE OPENING FORCE OF ALL EXTERIOR PUSH/PULL DOORS SHALL NOT EXCEED 8 1/2 LBS.

THE OPENING FORCE OF ALL INTERIOR PUSH/PULL DOORS SHALL NOT EXCEED 5 LBS.

PROVIDE PANIC HARDWARE FOR ALL EXTERIOR DOORS AS NOTED ON THE DOOR SCHEDULE.

ALL DOOR HARDWARE SHALL NOT REQUIRE TIGHT GRASPING, TIGHT PINCHING, OR TWISTING OF THE WRIST TO OPERATE.

PROTECT FROM DAMAGE DURING CONSTRUCTION ALL EXISTING WALLS, FLOORS, CEILINGS, ETC... THAT ARE TO REMAIN, CONTRACTOR TO PATCH & REPAIR ANY DAMAGED PORTIONS OF THE EXISTING BUILDING AS REQUIRED TO MATCH THE EXISTING ADJACENT CONSTRUCTION & FINISHES.

G.C. TO NOTIFY ACM IF EXISTING MODULAR FRONT COUNTER IS CORE DRILLED.

GC TO VERIFY SPRINKLER HEADS IN FIELD AND NOTIFY ACM.

NEW FINISHES TO MATCH EXISTING. GC TO REFERENCE DECOR AND VERIFY IN FIELD.

## KEY FLOOR PLAN NOTES

- CP 1 — CP1–DARK CURATED VIEW PANEL: COLOR: WILSONART – STEEL MESH 4879–38
  CP2–LIGHT CURATED VIEW PANEL: COLOR: WILSONART – FASHION GRAY D381–60
  NOTE: GC TO RECEIVE CURATED PANEL MOUNTS FROM S&D VENDOR
- MB — PORTRAIT MENU BOARDS WITH BEVEL
- SCH BV — BV1–DARK SCHLUTER: 3/8" QUADEC TRENDLINE. COLOR: TUSCAN PEWTER
  BV2–LIGHT SCHLUTER: 3/8" DECO COLOR: SATIN ANODIZED ALUMINUM
- PS — NEW PICK–UP UNIT
- EC — NEW SERVICE POD FRONT COUNTER UNIT.
- BG — NEW BAKED GOODS UNIT. (NOT USED)
- EV — EXISTING VALANCE TO REMAIN
- NV — NEW VALANCE TO TIE INTO EXISTING. GC TO REFERENCE 6/DET1–A FOR FINISHES.
- OB — NEW ORDER READY BOARD
- FT — FLOOR TILE TO MATCH EXISTING. GC VERIFY SPEC IN FIELD.
- PL — PLASTIC LAMINATE TO MATCH EXISTING. GC TO VERIFY SPEC IN FIELD.
- K — EXISTING KIOSK (VERIFY WITH ACM & O/O).
- ACT AV — ACOUSTICAL CEILING TILE–VINYL FACED. COLOR:WHITE
- ND — NEW STAND–ALONE HAPPY MEAL DISPLAY.
- RA — RELOCATE EXISTING ANSUL PULL. GC TO REFER TO A1.0 FOR NEW LOCATION.
- EQ — RELOCATED/NEW EQUIPMENT
- MD — NEW SEPARATE McDELIVERY, BY CP

Date: 12/19/2023 By: BM

☐ Preliminary ☒ Final

☐ Exterior ☒ Interior ☐ Site ☐ SAM

☐ **APPROVED**

☒ **APPROVED WITH CHANGES AS NOTED**

☐ **REVISE & RESUBMIT**

**This information is being reviewed for McDonald's Brand Intent only and does not relieve the designer of responsibility for regulatory/code compliance as well as implementation of applicable McDonald's guidelines**

McDonald's USA, LLC

**KIOSK POWER AND DATA REQUIREMENTS**
PROVIDE POWER WITHIN CEILING FOR CONNECTION TO SELF ORDER KIOSKS. PROVIDE 2#12, 1#12 GRD., & 1#12 ISOLATED GROUND ON A 20A DEDICATED CIRCUIT FED FROM THE CP PANEL FOR EVERY KIOSK.

GC/ ELECTRICIAN TO VERIFY ELECTRICAL PLACEMENT IN CEILING. EXISTING CEILING TREATMENTS MAY CAUSE ISSUE.

**REFER TO USRD KIOSK GUIDELINES ON ACCESSMCD FOR ADDITIONAL INFORMATION**
(RESTAURANT DEVELOPMENT / EOTF / DIGITAL TAB)

All dimensions are hold dimensions and deviations must be coordinated with USRD

(2) Existing DS Kiosk to be relocated as shown.

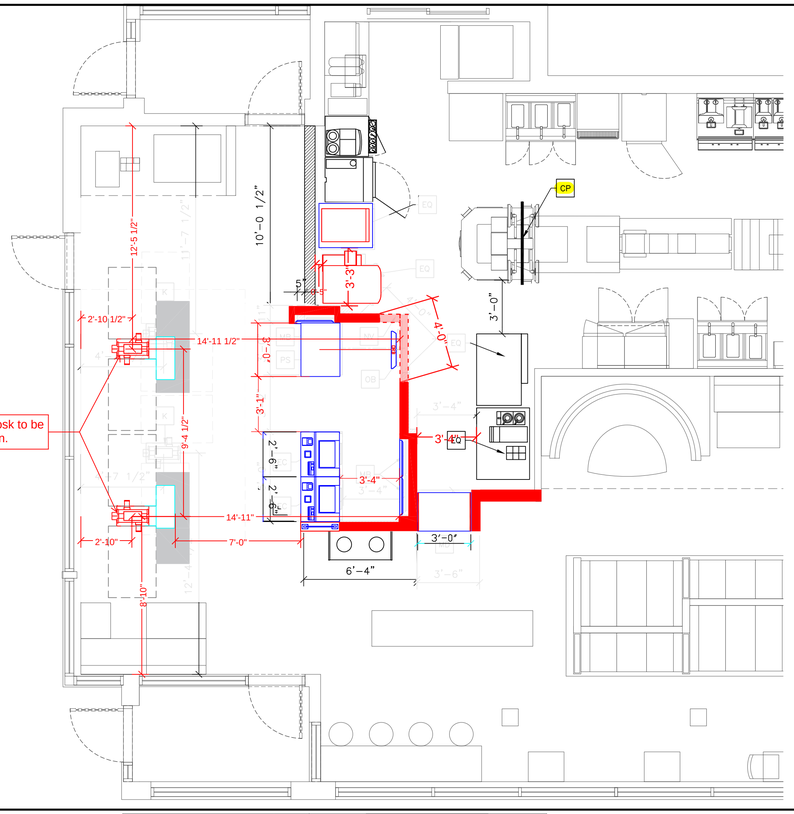


1 / A1.0 — **FRONT COUNTER PLAN**
1/4" = 1'–0"

ALL EXISTING DUCT WORK IS TO REMAIN, PROTECT & PRESERVE DURING DEMO, EXTEND EXISTING DUCTWORK AS NECESSARY TO ACCOMMODATE NEW DIFFUSER LAYOUT.

EXISTING LIGHTING TO BE ADJ./RELOCATED AS NECESSARY, PROTECT & PRESERVE DURING DEMO, VERIFY WITH AMC PIROR TO CONSTR. LIGHTING REQUIRMENTS.

EXISTING 2X2 LAY–IN CEILING TILE AND GRID TO REMAIN AS IS.

NEW 2X2 LAY–IN CEILING TILE AND GRID, ADJUST TO NEW LAYOUT.

EXISTING 2X2 LAY–IN CEILING TILE AND GRID TO REMAIN AS IS.

NEW 2X2 LAY–IN CEILING TILE AND GRID, ADJUST TO NEW LAYOUT.

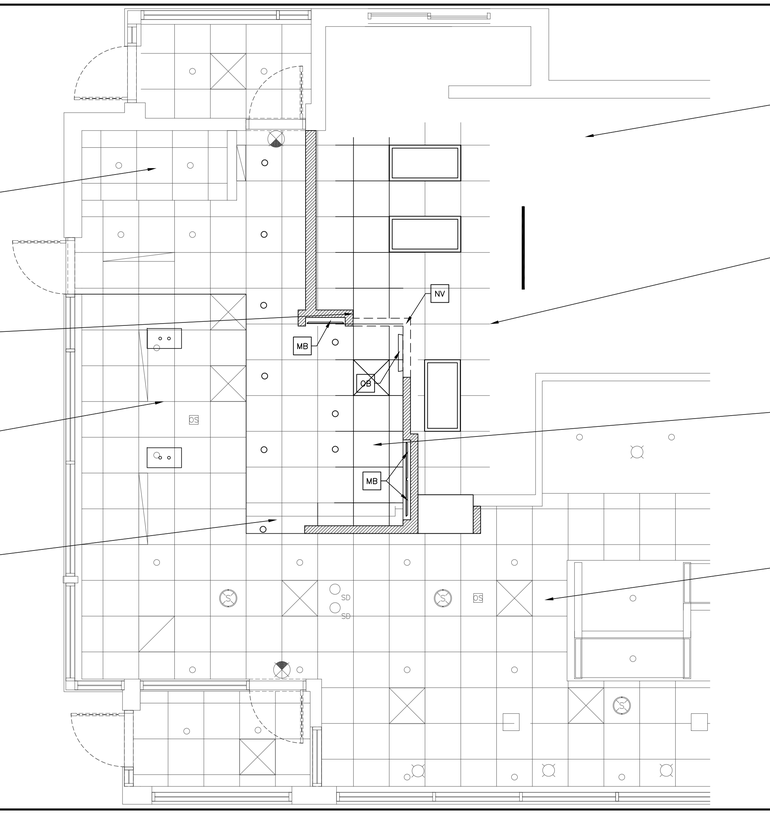


EXISTING 2X2 LAY–IN VINYL CEILING TILE AND GRID TO REMAIN AS IS.

TIE–IN TO EXISTING 2X2 LAY–IN VINYL CEILING TILE AND GRID

NEW 2X2 LAY–IN CEILING TILE AND GRID, ADJUST TO NEW LAYOUT.

EXISTING 2X2 LAY–IN CEILING TILE AND GRID TO REMAIN AS IS.

2 / A1.0 — **FRONT COUNTER RCP**
1/4" = 1'–0"

| REV | DATE | DESCRIPTION | BY |
|---|---|---|---|

PREPARED BY:
Robert Kempkes
ARCHITECT
2915 CENTRAL AVE, STE 2A
HOT SPRINGS, AR 71901
PHONE 501.538.9600
FAX 501.538.9601 ARKANSAS LICENSE #RA2400679


PREPARED FOR: McDonald's USA, LLC
© 2015 McDonald's USA, LLC
These drawings and specifications are the confidential and proprietary property of McDonald's USA, LLC and shall not be copied or reproduced without written authorization. The contract documents were prepared for use on this specific site in conjunction with its issue date and are not suitable for use on any other project. Any use of, or reliance upon these drawings for reference or example on another project requires the services of properly licensed architects and engineers. Reproduction of the contract documents for reuse on another project is not authorized


| | |
|---|---|
| DRAWN BY | MP |
| STD ISSUE DATE | FEB 2023 |
| REVIEWED BY | R.K. |
| DATE ISSUED | 10/23/2023 |

TITLE: McDONALD'S SAO BACKAST EXISTING EXTERIOR
DESCRIPTION: INTERIOR SREVICE AREA REMODEL NEW SERVICE POD COUNTER
SITE ID: 024–0428
SITE ADDRESS: 1361 STATE HWY 248
BRANSON, MO

SHEET NO. 024–0428.00.0
**A1.0**
FLOOR PLAN