GENERAL FLOOR PLAN NOTES

ALL EXIT DOORS SHALL BE KEYLESS IN THE DIRECTION OF EGRESS.

THE OPENING FORCE OF ALL EXTERIOR PUSH/PULL DOORS SHALL NOT EXCEED 8 1/2 LBS.

THE OPENING FORCE OF ALL INTERIOR PUSH/PULL DOORS SHALL NOT EXCEED 5 LBS.

PROVIDE PANIC HARDWARE FOR ALL EXTERIOR DOORS AS NOTED ON THE DOOR SCHEDULE.

ALL DOOR HARDWARE SHALL NOT REQUIRE TIGHT GRASPING, TIGHT PINCHING, OR TWISTING OF THE WRIST TO OPERATE.

PROTECT FROM DAMAGE DURING CONSTRUCTION ALL EXISTING WALLS, FLOORS, CEILINGS, ETC... THAT ARE TO REMAIN, CONTRACTOR TO PATCH & REPAIR ANY DAMAGED PORTIONS OF THE EXISTING BUILDING AS REQUIRED TO MATCH THE EXISTING ADJACENT CONSTRUCTION & FINISHES.

G.C. TO NOTIFY ACM IF EXISTING MODULAR FRONT COUNTER IS CORE DRILLED.

GC TO VERIFY SPRINKLER HEADS IN FIELD AND NOTIFY ACM.

NEW FINISHES TO MATCH EXISTING. GC TO REFERENCE DECOR AND VERIFY IN FIELD.

EXISTING LIGHTING TO BE ADJ./RELOCATED AS NEEDED. NOTIFY AMC PRIOR TO CONSTR. IF NEW OR ADDITIANAL LIGHTING IS REQUIRED.

KEY FLOOR PLAN NOTES

CP 1 — CP1–DARK CURATED VIEW PANEL:
COLOR: WILSONART – STEEL MESH 4879–38

CP2–LIGHT CURATED VIEW PANEL:
COLOR: WILSONART – FASHION GRAY D381–60

NOTE: GC TO RECEIVE CURATED PANEL MOUNTS FROM S&D VENDOR

MB — PORTRAIT MENU BOARDS WITH BEVEL

SCH BV — BV1–DARK SCHLUTER: 3/8" QUADEC TRENDLINE.
COLOR: TUSCAN PEWTER

BV2–LIGHT SCHLUTER: 3/8" DECO
COLOR: SATIN ANODIZED ALUMINUM

PS — NEW PICK–UP UNIT

C — NEW SAO COUNTER POD UNIT.

BG — NEW BAKED GOODS UNIT. (NOT USED)

EV — EXISTING VALANCE TO REMAIN

NV — NEW VALANCE TO TIE INTO EXISTING. GC TO REFERENCE 6/DET1–A FOR FINISHES.

OB — NEW ORDER READY BOARD

FT — FLOOR TILE TO MATCH EXISTING. GC VERIFY SPEC IN FIELD.

PL — PLASTIC LAMINATE TO MATCH EXISTING. GC TO VERIFY SPEC IN FIELD.

K — EXISTING KIOSK TO REMAIN.

ACT AV — ACOUSTICAL CEILING TILE–VINYL FACED.
COLOR:WHITE

ND — NEW STAND–ALONE HAPPY MEAL DISPLAY.

RA — RELOCATE EXISTING ANSUL PULL. GC TO REFER TO A1.0 FOR NEW LOCATION.

FA — PROVIDE 5–20R RECEPTACLE FOR FUTURE DELIVERY TABLET AT 2'–0" AFF. EXTEND NEARBY APPLIANCE PANEL CIRCUIT TO NEW RECEPTACLE. VERIFY CIRCUIT HAS 1.5 AMPS OF AVAILABLE AMPACITY.

EXISTING ELECTRICAL TO BE ADJ./RELOCATED AS NECESSARY, PROTECT & PRESERVE DURING DEMO, VERIFY WITH AMC PIROR TO CONSTR. LIGHTING REQUIRMENTS.

Date: 03/07/2024 By: AE
☐ Preliminary ☒ Final
☐ Exterior ☒ Interior ☐ Site ☐ SAM

☐ APPROVED
☒ APPROVED WITH CHANGES AS NOTED
☐ REVISE & RESUBMIT

This information is being reviewed for McDonald's Brand Intent only and does not relieve the designer of responsibility for regulatory/code compliance as well as implementation of applicable McDonald's guidelines

McDonald's USA, LLC

KIOSK POWER AND DATA REQUIREMENTS
PROVIDE POWER WITHIN CEILING FOR CONNECTION TO SELF ORDER KIOSKS. PROVIDE 2#12, 1#12 GRD., & 1#12 ISOLATED GROUND ON A 20A DEDICATED CIRCUIT FED FROM THE CP PANEL FOR EVERY KIOSK.

GC/ ELECTRICIAN TO VERIFY ELECTRICAL PLACEMENT IN CEILING. EXISTING CEILING TREATMENTS MAY CAUSE ISSUE.

REFER TO USRD KIOSK GUIDELINES ON ACCESSMCD FOR ADDITIONAL INFORMATION
(RESTAURANT DEVELOPMENT / EOTF / DIGITAL TAB)

All dimensions are hold dimensions and deviations must be coordinated with USRD

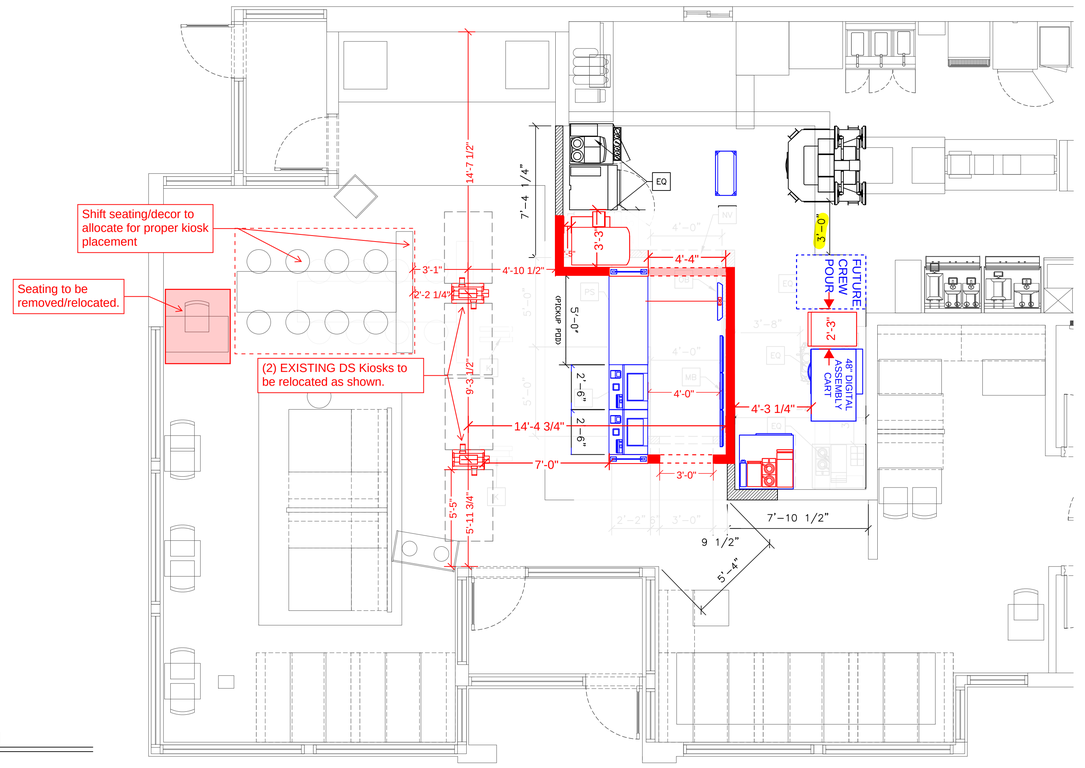

1 / A1.0 — **FRONT COUNTER PLAN**
1/4" = 1'–0"

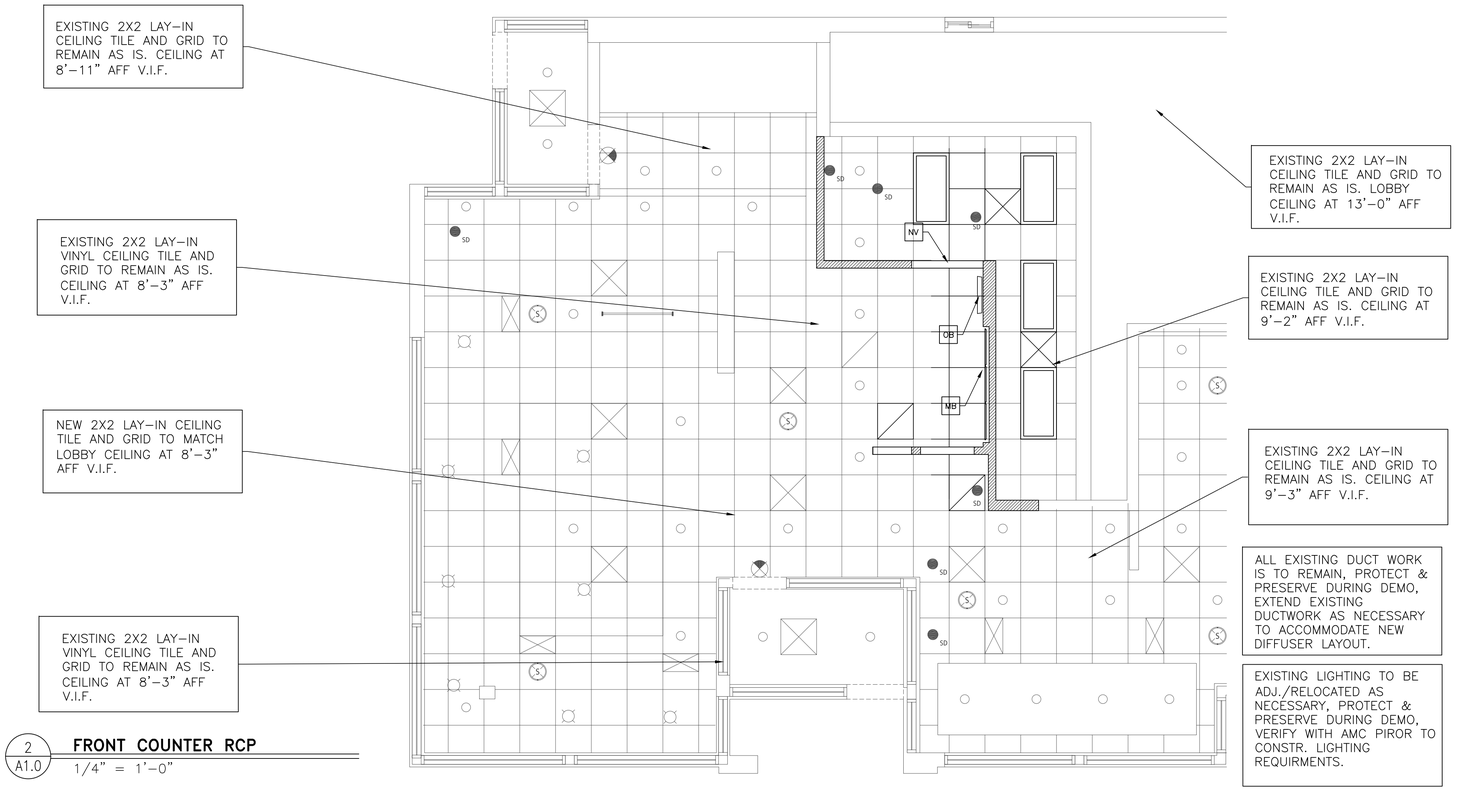

2 / A1.0 — **FRONT COUNTER RCP**
1/4" = 1'–0"

REV	DATE	DESCRIPTION	BY

PREPARED BY:
Robert Kempkes
ARCHITECT
20 EUSTIS AVE., STE 2A
BELLEAIR, FL 33756
PHONE 727.442.4679
FAX 866.NEW.PLANS (866.639.7526)

PREPARED FOR:
McDonald's USA, LLC

© 2023 McDonald's USA, LLC
These drawings and specifications are the confidential and proprietary property of McDonald's USA, LLC and shall not be copied or reproduced without written authorization. The contract documents were prepared for use on this specific site in conjunction with its issue date and are not suitable for use on any other project. Use and reuse of these drawings for reference or example on another project requires the services of properly licensed architects and engineers. Reproduction of the contract documents for reuse on another project is not authorized.

DRAWN BY	SO
STD ISSUE DATE	FEB. 2023
REVIEWED BY	R.K.
DATE ISSUED	10/15/2023

TITLE: McDONALD'S LEGACY SAO BACKCAST EXISTING EXTERIOR
DESCRIPTION: PARTIAL INTERIOR REMODEL SERVICE AREA OPTIMIZATION
SITE ADDRESS: 381 HWY Z
ST. ROBERT, MO
SITE ID: 024–1041

SHEET NO.: 024–1041.00.0
A1.0
FLOOR PLAN