McDonalds Existing Conditions

360° Virtual Tour

sevan MULTI-SITE SOLUTIONS

STOREFRONT

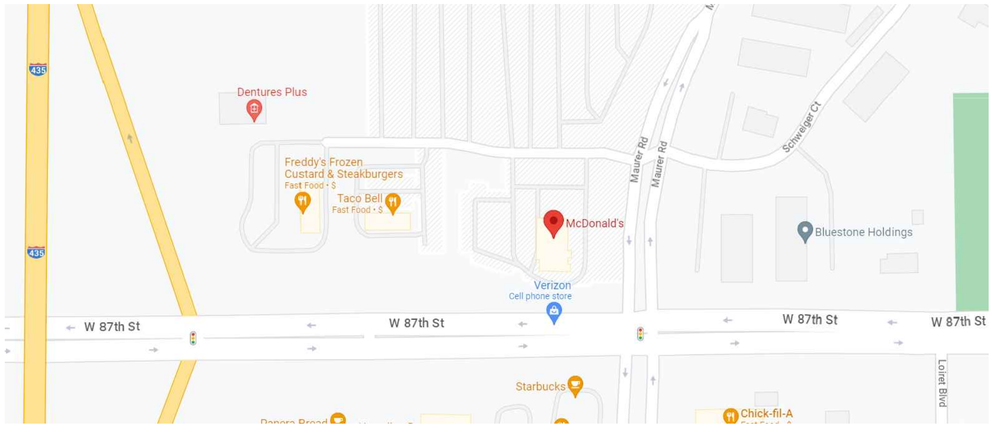

VICINITY MAP

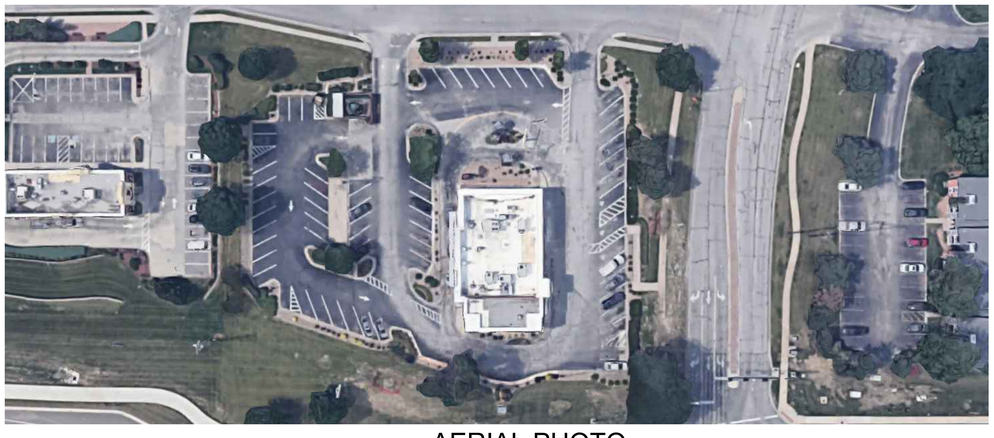

AERIAL PHOTO

Store Name:	LENEXA/87TH/435
National Store No.	015–0162
Store ID:	11671
Address:	15920 W 87TH ST PKY LENEXA ,KS 66215

360° sevan SURVEY

CLICK FOR A VIRTUAL TOUR

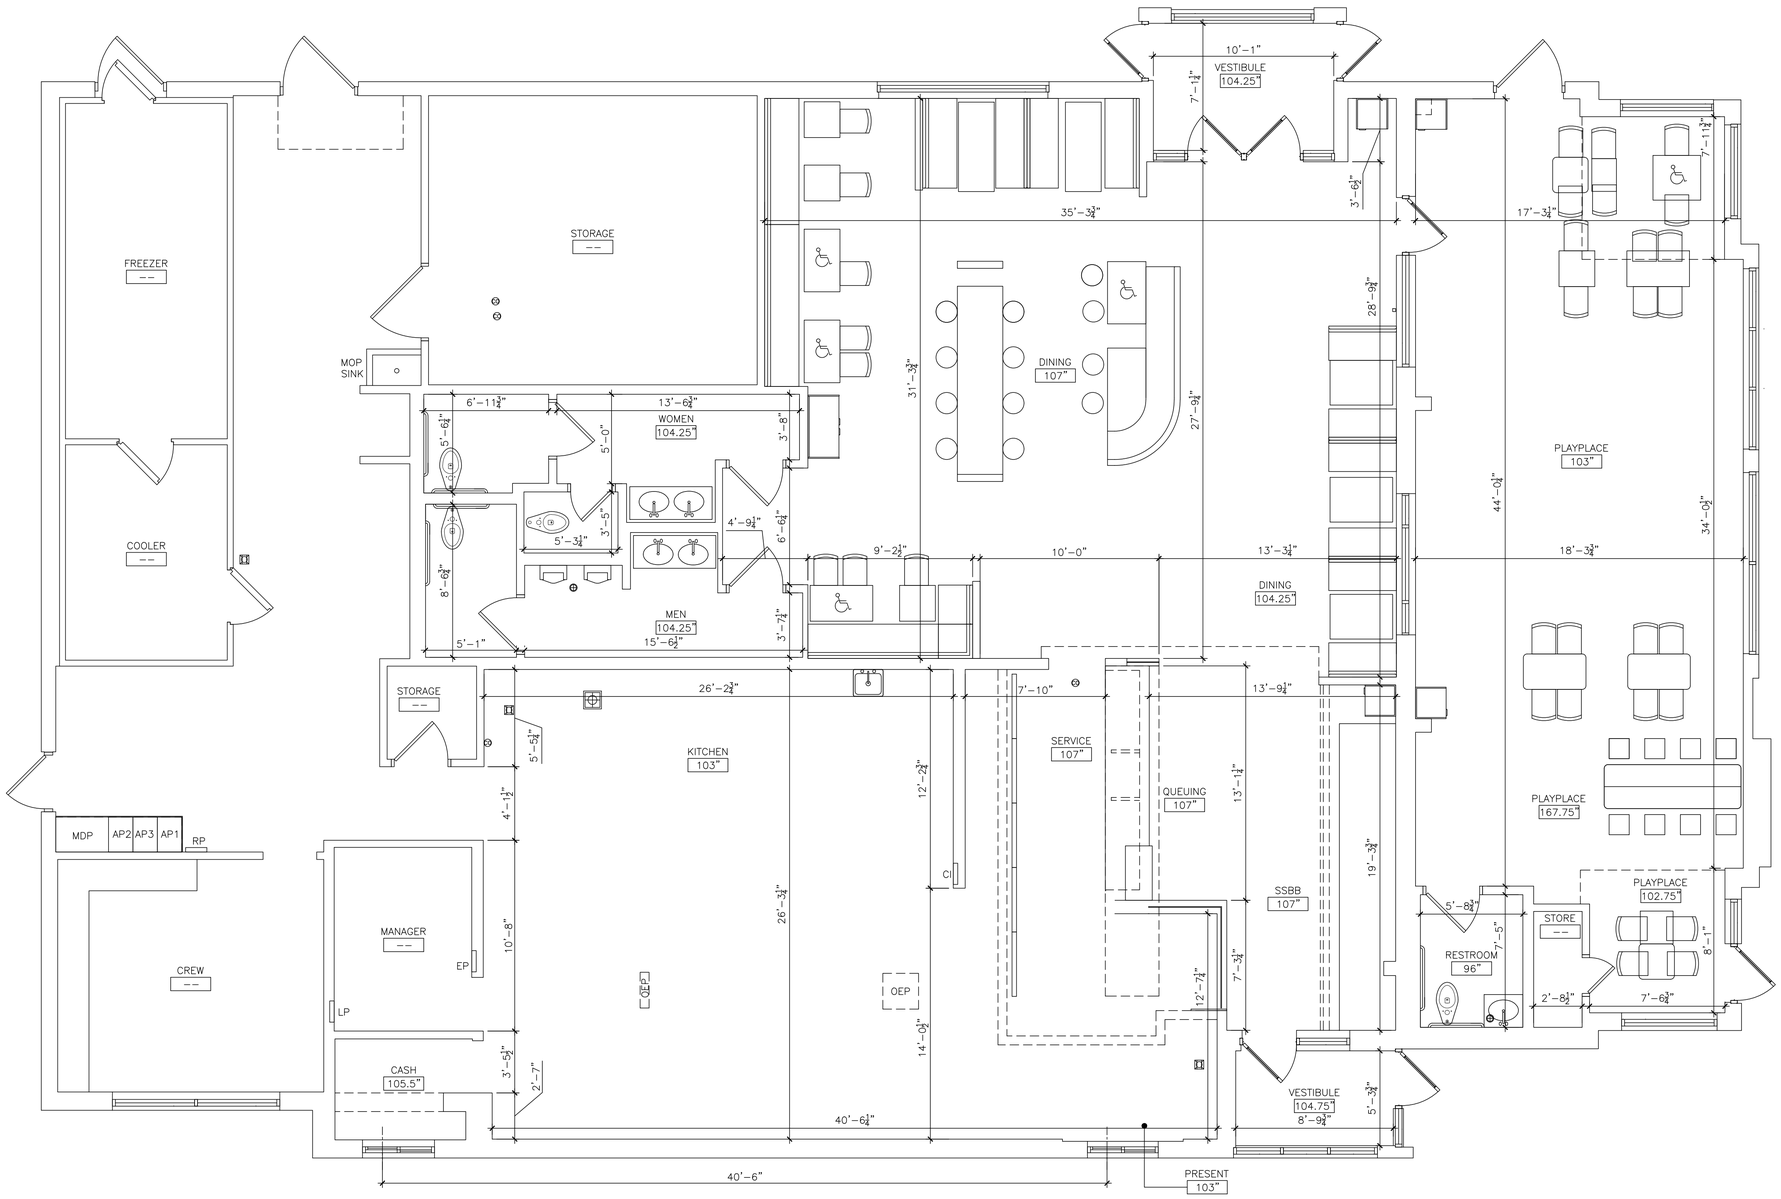

N

1 / A1.0 EXISTING FLOOR PLAN – LEVEL 1

SCALE: 1/4" = 1'-0"

TOTAL SQ FT = 5,634

TOTAL SEATING = 88

sevan
MULTI-SITE SOLUTIONS
DESIGN LLC.

Regional Office:
37704 Hills Tech Drive
Farmington Hills, MI 48331
Telephone: 734-367-4445

Corporate Office:
3025 Highland Parkway #850
Downers Grove, IL 60515
info@sevansolutions.com www.sevansolutions.com

SAFETY - INTEGRITY - SUSTAINABILITY

REVISIONS

NO.	DATE	DESCRIPTION
–	–	–
–	–	–
–	–	–
–	–	–
–	–	–

SEAL

SEAL NOTE

PREPARED FOR

McDonald's USA LLC

These drawings and specifications are the confidential and proprietary property of McDonald's USA, LLC and shall not be copied or reproduced without written authorization. The contract documents were prepared for use on this specific site in conjunction with its issue date and are not suitable for use on a different site or at a later time. Use of these drawings for reference or example on another project requires the services of properly licensed architects and engineers. Reproduction of the contract documents for reuse on another project is not authorized.

PROJECT DESCRIPTION

EXISTING CONDITIONS

PROJECT LOCATION

McDonald's
15920 W 87TH ST PKY
LENEXA, KS 66215

SHEET TITLE

FLOOR PLAN

SHEET MANAGEMENT

PROJECT NO.:	015–0162
DATE ISSUED:	05/23/2023
DRAWN BY:	GT
REVIEWED BY:	JA

NATIONAL STORE #
11671

SHEET NUMBER

A1.0

EX. FLOOR PLAN

Submittal Type – AS-BUILT

W:\Shared\Clients\McDonalds\Survey and P2P\2020_Denver Field Office\Market_Heartland\015-0162 (11671) SAO\015-0162 (11671) CAD\Current\CAD- SAO\015-0162 (11671) As Built CAD.dwg May 24, 2023 - 4:30pm Aguilerojoel

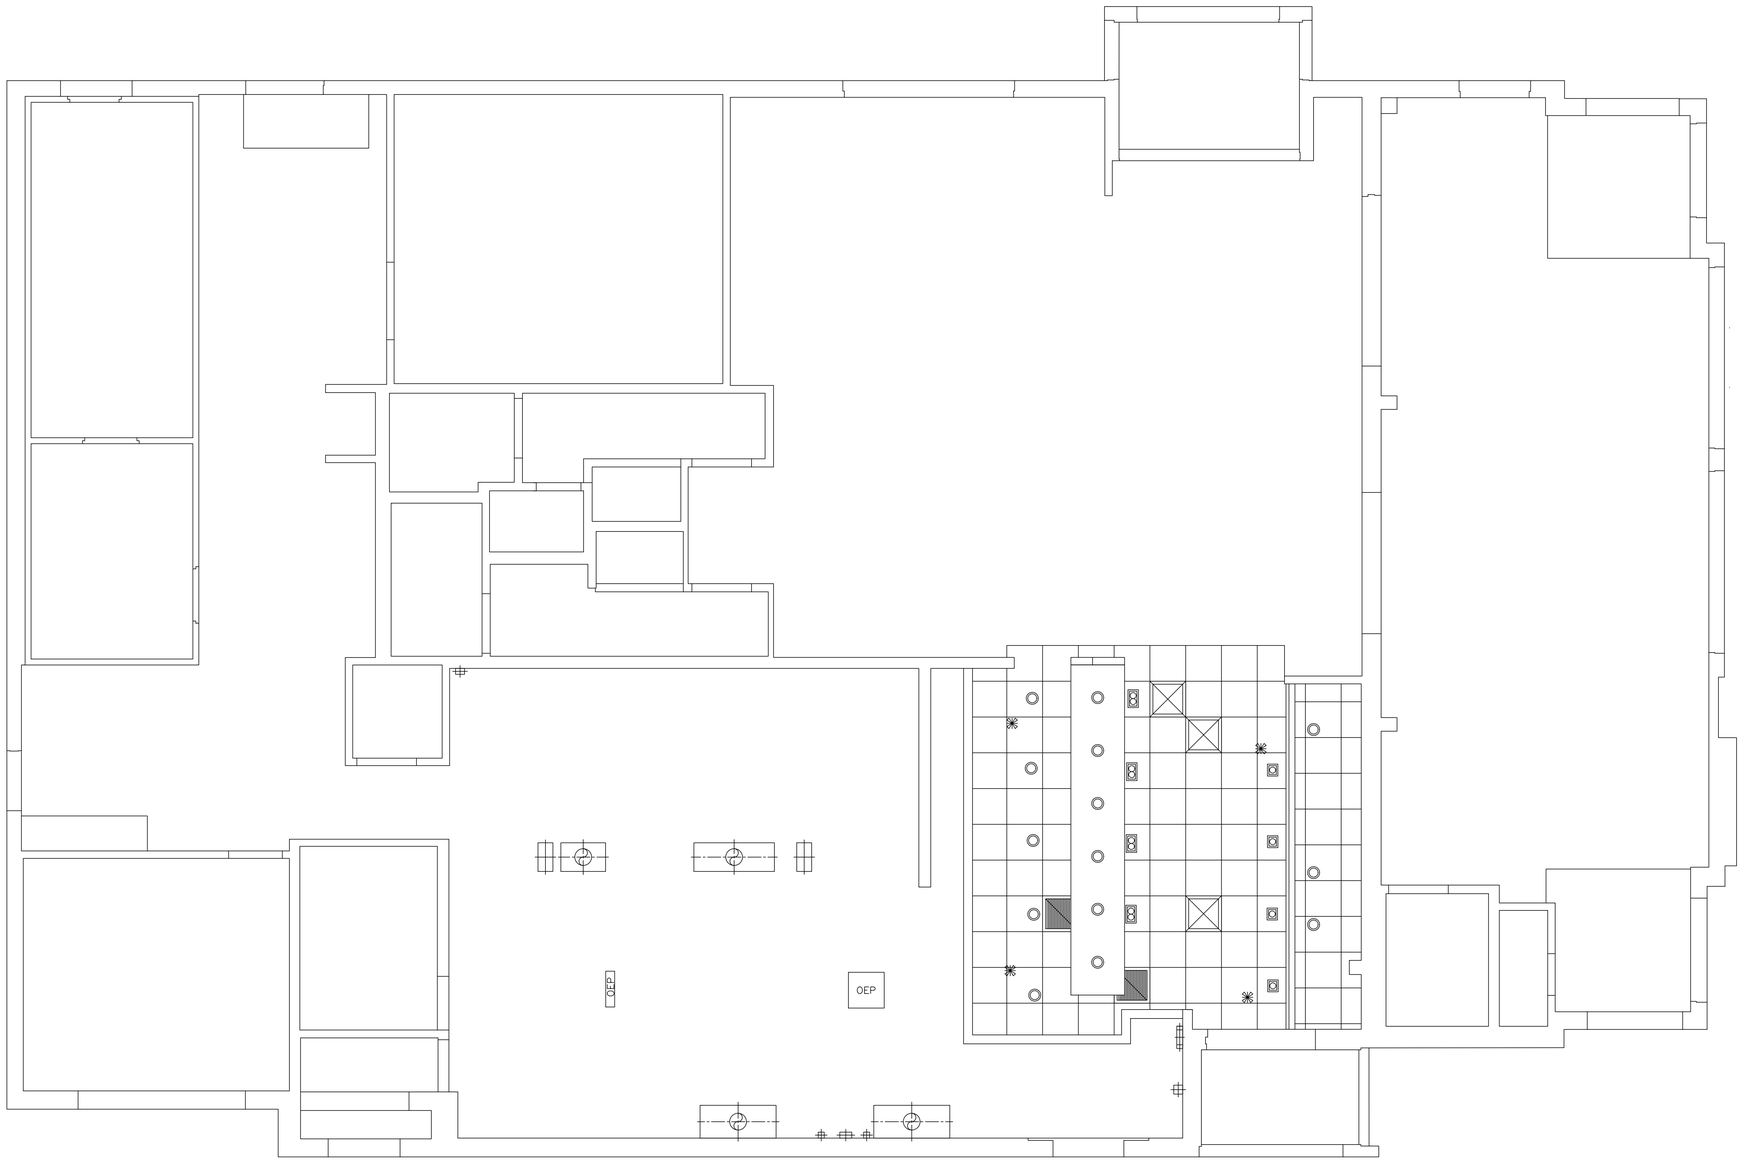

N

1 / A1.1 EXISTING REFLECTED CEILING PLAN

SCALE: 1/4" = 1'-0"

sevan
MULTI-SITE SOLUTIONS
DESIGN LLC.

Regional Office:
37704 Hills Tech Drive
Farmington Hills, MI 48331
Telephone: 734-367-4445

Corporate Office:
3025 Highland Parkway #850
Downers Grove, IL 60515
info@sevansolutions.com www.sevansolutions.com

SAFETY - INTEGRITY - SUSTAINABILITY

REVISIONS

NO.	DATE	DESCRIPTION
–	–	–
		–
–	–	–
		–
–	–	–
		–
–	–	–
		–
–	–	–
		–

SEAL

SEAL NOTE

PREPARED FOR

McDonald's USA LLC

These drawings and specifications are the confidential and proprietary property of McDonald's USA, LLC and shall not be copied or reproduced without written authorization. The contract documents were prepared for use on this specific site in conjunction with its issue date and are not suitable for use on a different site or at a later time. Use of these drawings for reference or example on another project requires the services of properly licensed architects and engineers. Reproduction of the contract documents for reuse on another project is not authorized.

PROJECT DESCRIPTION

EXISTING CONDITIONS

PROJECT LOCATION

McDonald's
15920 W 87TH ST PKY
LENEXA, KS 66215

SHEET TITLE

REFLECTED CEILING PLAN

SHEET MANAGEMENT

PROJECT NO.:	015-0162
DATE ISSUED:	05/23/2023
DRAWN BY:	GT
REVIEWED BY:	JA

NATIONAL STORE #

11671

SHEET NUMBER

A1.1

EX. RCP

Submittal Type – AS-BUILT

W:\Shared\Clients\McDonalds\Survey and PZP\2020_Denver Field Office\Market_Heartland\015-0162 (11671) SAO\015-0162 (11671) CAD\Current\CAD- SAO\015-0162 (11671) As Built CAD.dwg May 24, 2023 - 4:30pm Aguilerojoel

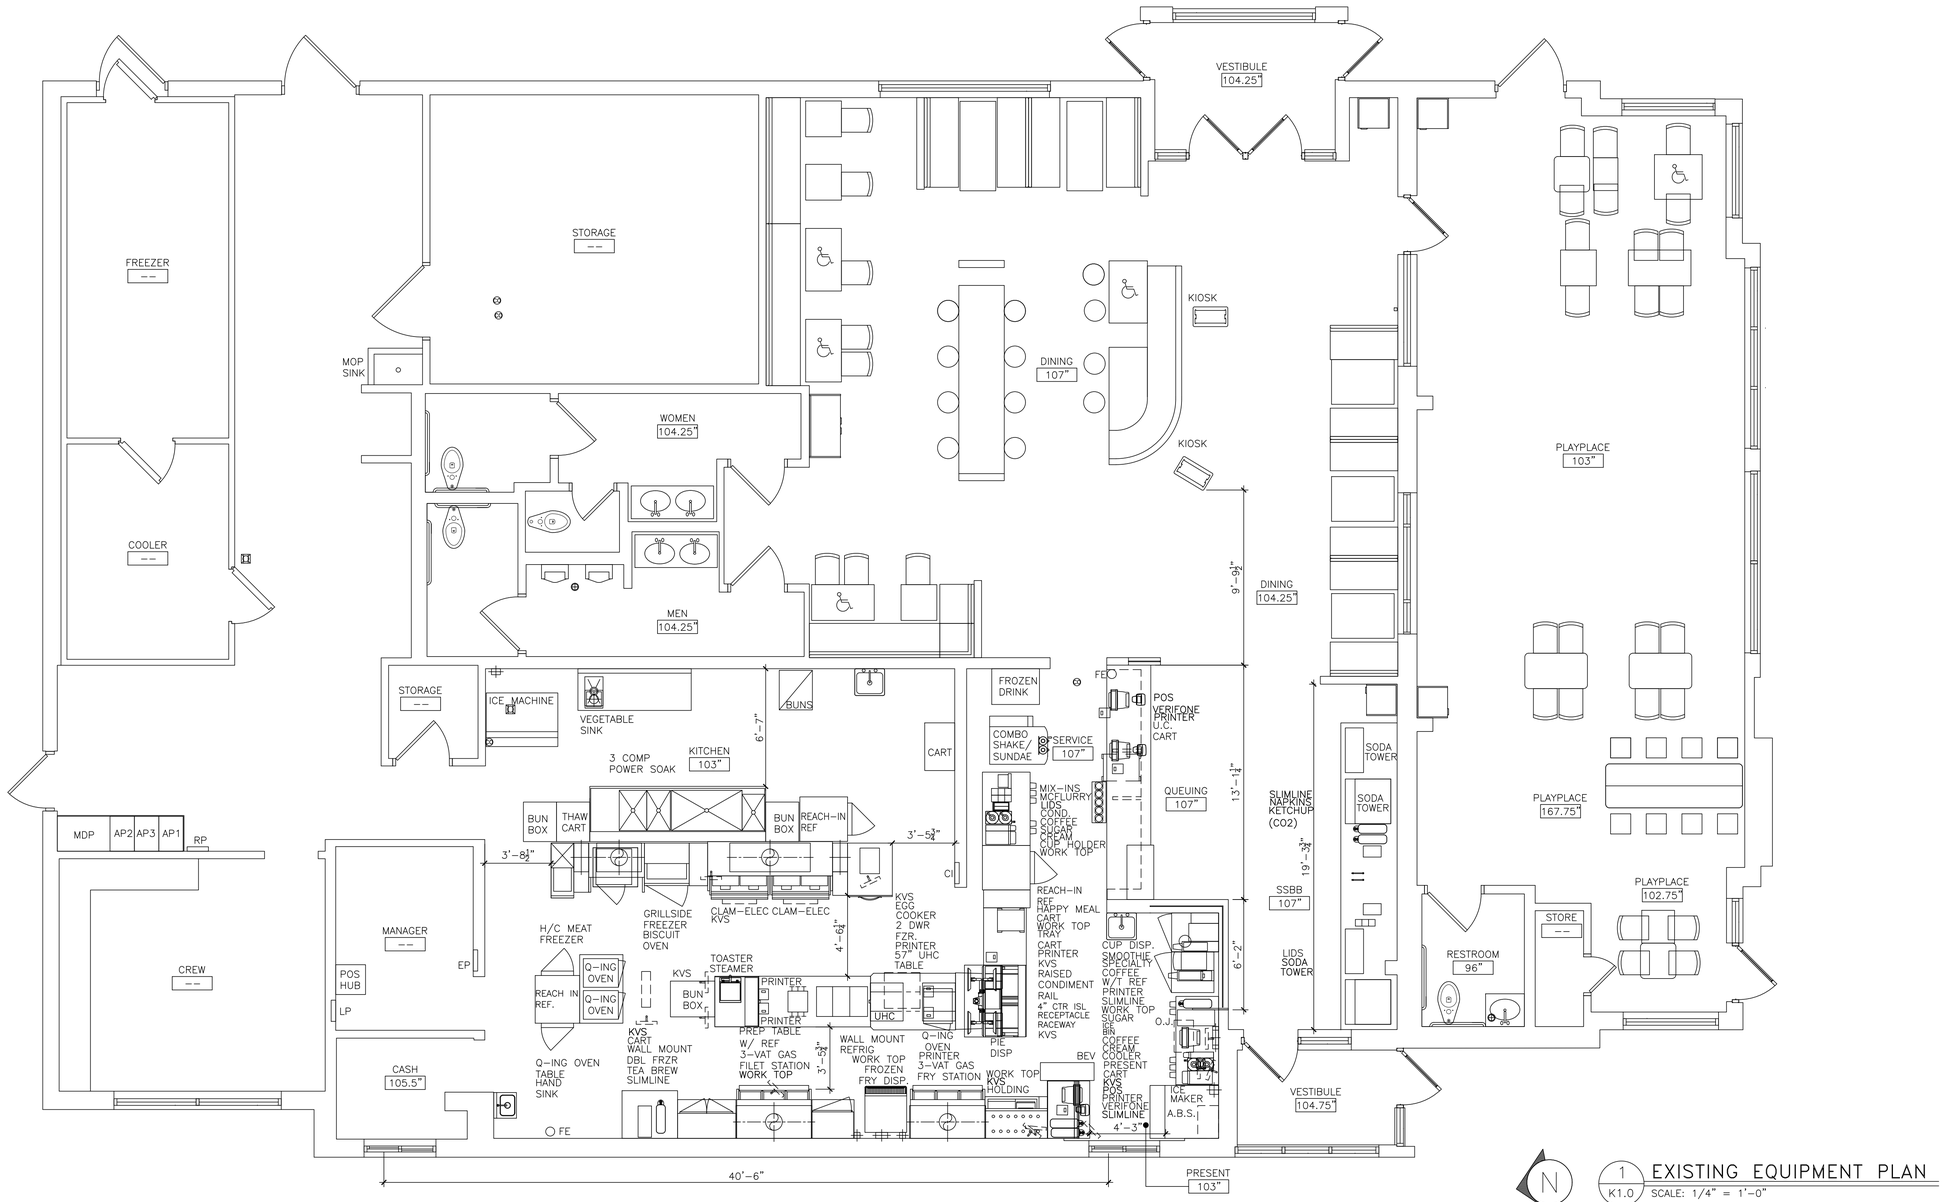

1 K1.0 EXISTING EQUIPMENT PLAN
SCALE: 1/4" = 1'-0"

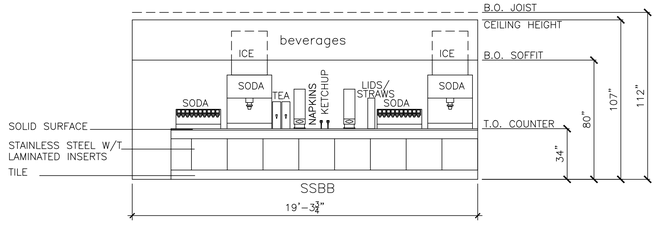

2 K1.0 EXISTING SSBB COUNTER ELEVATION
SCALE: 1/4" = 1'-0"

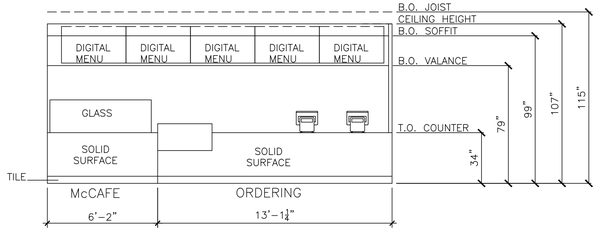

3 K1.0 EXISTING FRONT COUNTER ELEVATION
SCALE: 1/4" = 1'-0"

sevan
MULTI-SITE SOLUTIONS
DESIGN LLC.

Regional Office:
37704 Hills Tech Drive
Farmington Hills, MI 48331
Telephone: 734-367-4445

Corporate Office:
3025 Highland Parkway #850
Downers Grove, IL 60515
info@sevansolutions.com www.sevansolutions.com

SAFETY - INTEGRITY - SUSTAINABILITY

REVISIONS

NO.	DATE	DESCRIPTION
–	–	–
–	–	–
–	–	–
–	–	–
–	–	–

SEAL

SEAL NOTE

PREPARED FOR

McDonald's USA LLC

These drawings and specifications are the confidential and proprietary property of McDonald's USA, LLC and shall not be copied or reproduced without written authorization. The contract documents were prepared for use on this specific site in conjunction with its issue date and are not suitable for use on a different site or at a later time. Use of these drawings for reference or example on another project requires the services of properly licensed architects and engineers. Reproduction of the contract documents for reuse on another project is not authorized.

PROJECT DESCRIPTION

EXISTING CONDITIONS

PROJECT LOCATION

McDonald's
15920 W 87TH ST PKY
LENEXA, KS 66215

SHEET TITLE

KITCHEN EQUIPMENT PLAN

SHEET MANAGEMENT

PROJECT NO.:	015-0162
DATE ISSUED:	05/23/2023
DRAWN BY:	GT
REVIEWED BY:	JA

NATIONAL STORE #
11671

SHEET NUMBER

K1.0
EX. EQUIPMENT PLAN

Submittal Type – AS-BUILT

W:\Shared\Clients\McDonalds\Survey and P2P\2020_Denver Field Office\Market_Heartland\015-0162 (11671) SAO\015-0162 (11671) CAD\Current\CAD- SAO\015-0162 (11671) As Built CAD.dwg May 24, 2023 - 4:30pm Aguileroloel